


## U. S. PUBLIC LAND SURVEY MONUMENT RECORD

SECTION 29 T 18 N, R 5 W, TOWN OF FARMINGTON

LA CROSSE COUNTY

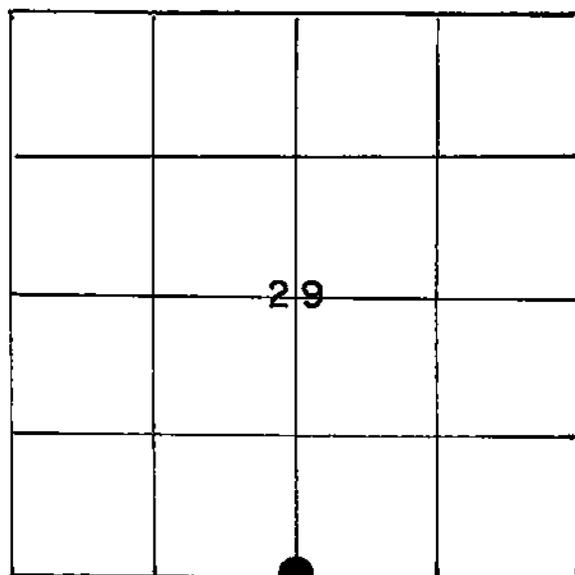

LOCATION OF LANDMARK

Crew: William C. Jung  
Perry DahlCrew: William C. Jung  
Peter Follansbee  
5/16/95

WISCONSIN COORDINATE SYSTEM

North

East

Theta Angle

Horiz. Order

Vert. Order

TYPE OF LANDMARK

~~Iron pipe~~ Lunde marker

BEARINGS ARE REFERENCED TO

True North

Describe any record evidence, monument evidence, testimonial evidence or any other material evidence you considered and whether the monument was found or restored through acceptance of an obliterated evidence location.

I accepted the old occupied fence corner as the best available evidence of the original government corner.

The iron pipe was removed and replaced with a brass capped Lunde marker. A sign and post were set nearby. A wine bottle with shell casing was buried with the marker.

Describe or show any material discrepancy between the location of the restored corner and that of the corner previously restored or reestablished.


None known.

RECORD OF DURABLE WITNESS MONUMENTS  
MAGNETIC


cloth tape distances?

NO	DESCRIPTION	BEARING	DISTANCE
1	Double blazed 12" aspen	N49°E	7.61
2	Double blazed 8" oak	N67°E	15.03
3	Double blazed 10" hickory	S44°E	14.36
4	Double blazed 10" hickory	S24°E	<del>33.94</del> 33.79

(Each distance is to a P.K. nail in a hack on the side of the tree.)

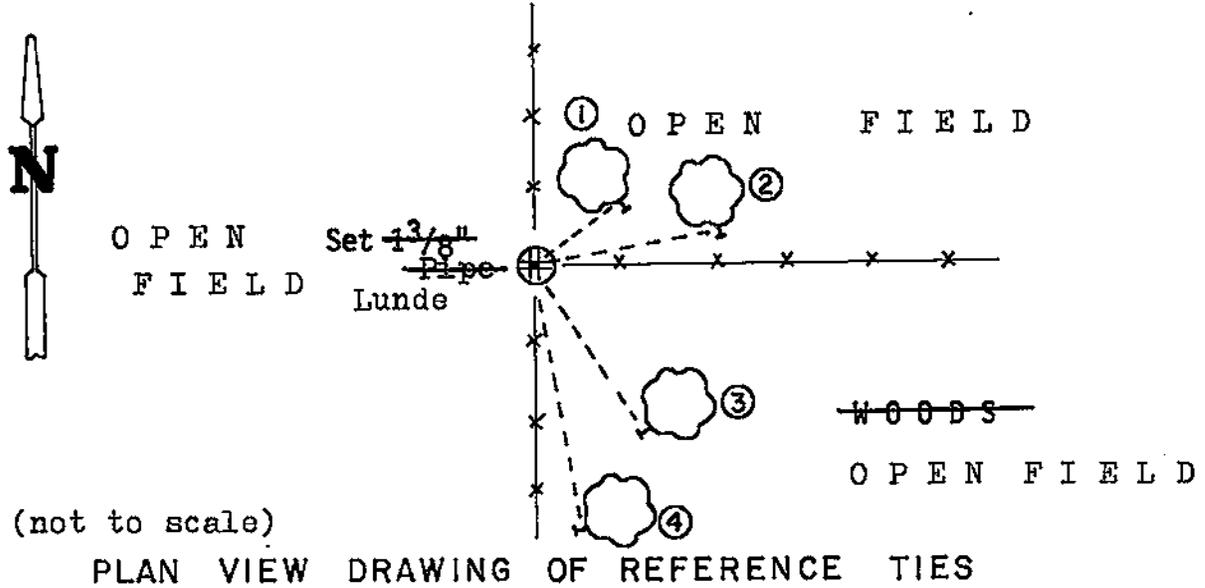

MAP SHOWING DISTANCE AND DIRECTION TO OTHER PUBLIC LAND SURVEY CORNERS USED FOR REESTABLISHING THE CORNER

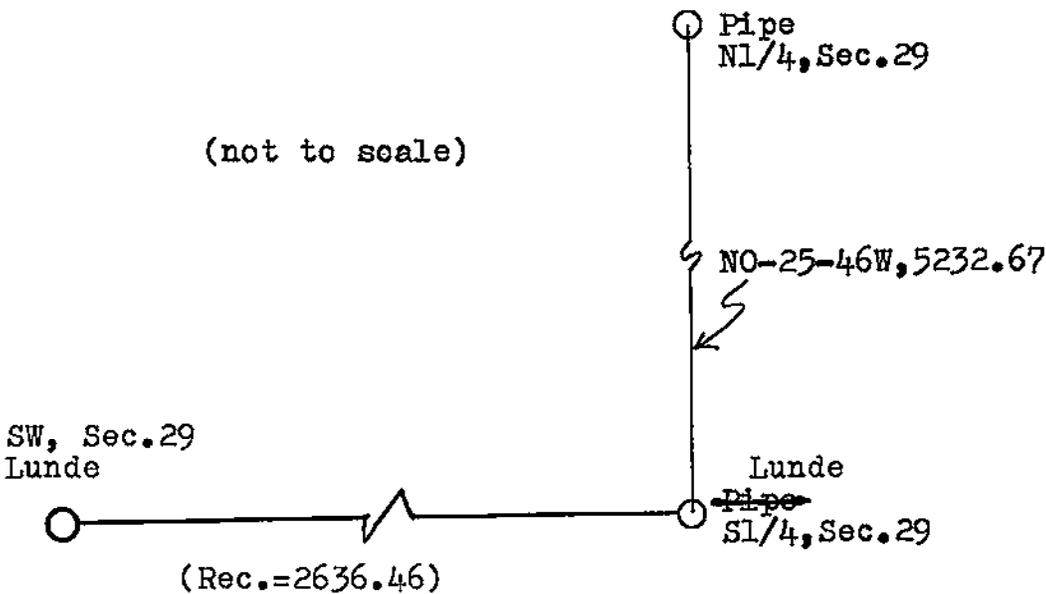

I, William C. Jung, Deputy County Surveyor,  
HEREBY CERTIFY THAT THE CORNER LOCATION SHOWN ON THIS RECORD  
WAS DETERMINED BY ME OR UNDER MY DIRECTION AND CONTROL AND  
THAT THIS U. S. PUBLIC LAND SURVEY MONUMENT RECORD IS CORRECT  
AND COMPLETE TO THE BEST OF MY KNOWLEDGE AND BELIEF.

William C. Jung  
Signature

December 27, 1985  
Date

Revised: August 17, 1995  
*awef*

