


## U. S. PUBLIC LAND SURVEY MONUMENT RECORD

SECTION 28 T 18 N, R 5 W, TOWN OF FARMINGTON

LA CROSSE COUNTY

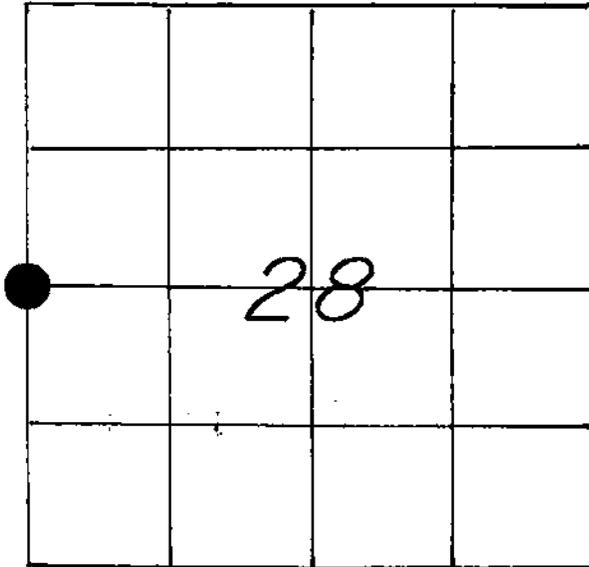

LOCATION OF LANDMARK

Crew: WILLIAM C. JUNG  
 PETER F, FOLLANSBEE  
 Date: 2/03/1997

Describe any record evidence, monument evidence, testimonial evidence or any other material evidence you considered and whether the monument was found or restored through acceptance of an obliterated evidence location.

I set the corner proportionately between the section corners and on line with the old North-South fences. An iron bar was set at the corner. This location fits the old occupied corner as there is also an old line fence to the West that matches this final location.

Describe or show any material discrepancy between the location of the restored corner and that of the corner previously restored or reestablished.

None Known.

## WISCONSIN COORDINATE SYSTEM

North

East

Theta Angle

Horiz. Order

Vert. Order

## TYPE OF LANDMARK


3/4" x 30" Iron Bar w/cap.

## BEARINGS ARE REFERENCED TO


Assumed North.

RECORD OF DURABLE WITNESS MONUMENTS  
MAGNETIC

NO	DESCRIPTION	BEARING	DISTANCE
1	Set P.K. Nail in NW-side 11" Hickory	S 11°W	19.23 Ft.
2	Set P.K. Nail in SW-side 5" Oak	S 20°E	25.59 Ft.
3	Set P.K. Nail in SW-side 4½" Oak	S 44°E	20.11 Ft.
4	Set P.K. Nail in SW-side 4½" Oak	S 55°E	26.46 Ft.

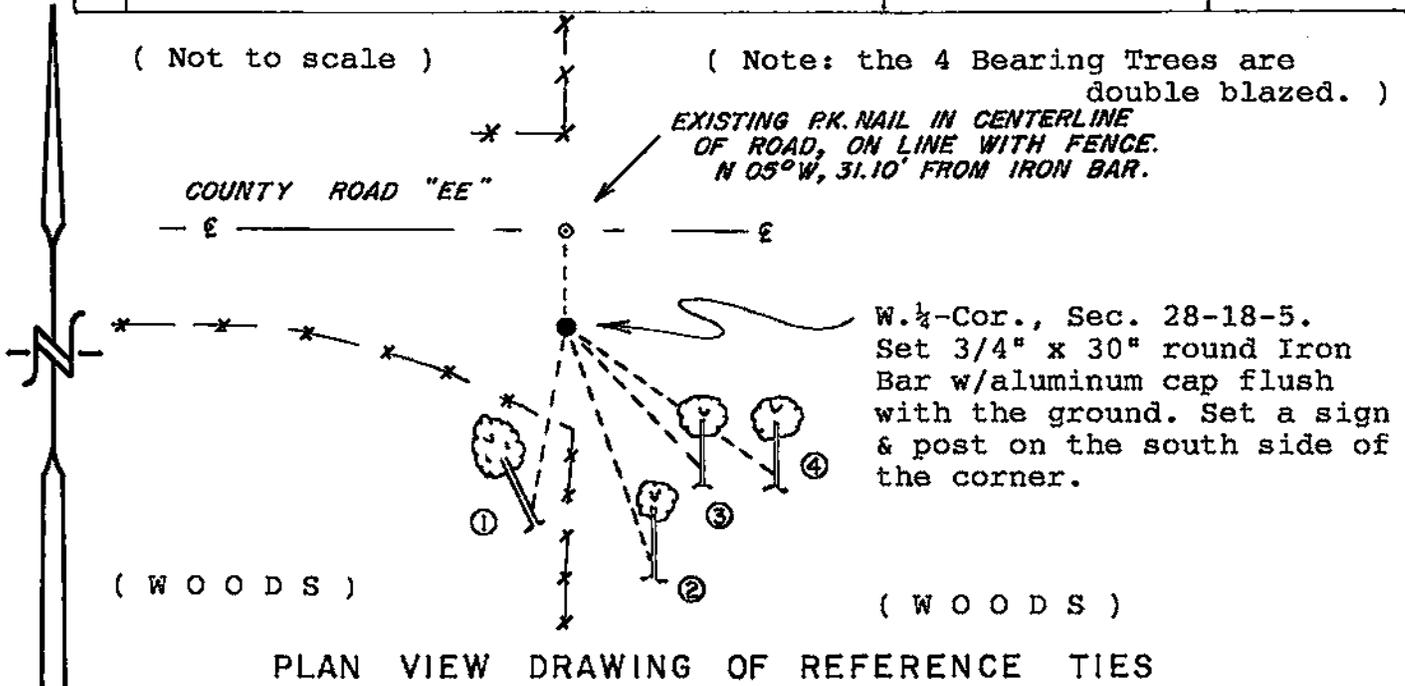

MAP SHOWING DISTANCE AND DIRECTION TO OTHER PUBLIC LAND SURVEY CORNERS USED FOR REESTABLISHING THE CORNER

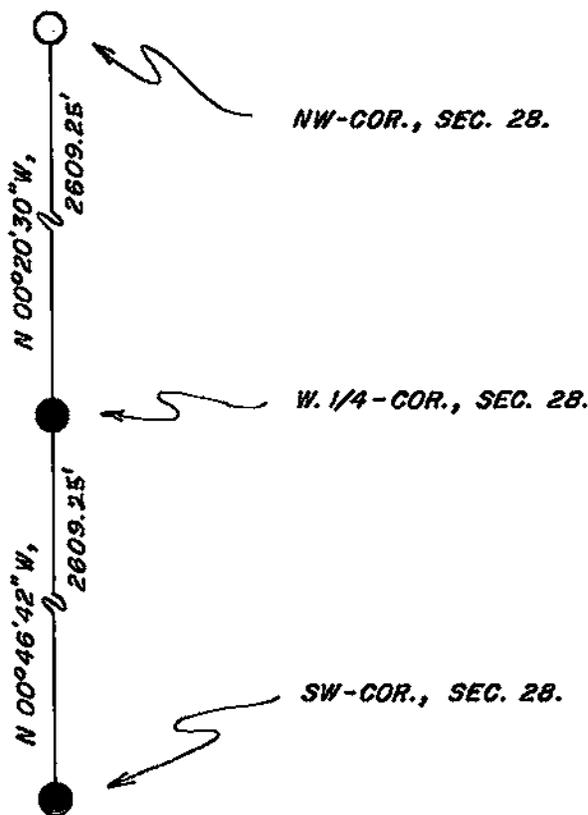

I, William C. Jung, County Surveyor  
HEREBY CERTIFY THAT THE CORNER LOCATION SHOWN ON THIS RECORD  
WAS DETERMINED BY ME OR UNDER MY DIRECTION AND CONTROL AND  
THAT THIS U. S. PUBLIC LAND SURVEY MONUMENT RECORD IS CORRECT  
AND COMPLETE TO THE BEST OF MY KNOWLEDGE AND BELIEF.

William C. Jung 6/12/97  
Signature Date



Seal