


## U. S. PUBLIC LAND SURVEY MONUMENT RECORD

SECTION 29 T 18 N, R 5 W, TOWN OF FARMINGTON  
LA CROSSE COUNTY

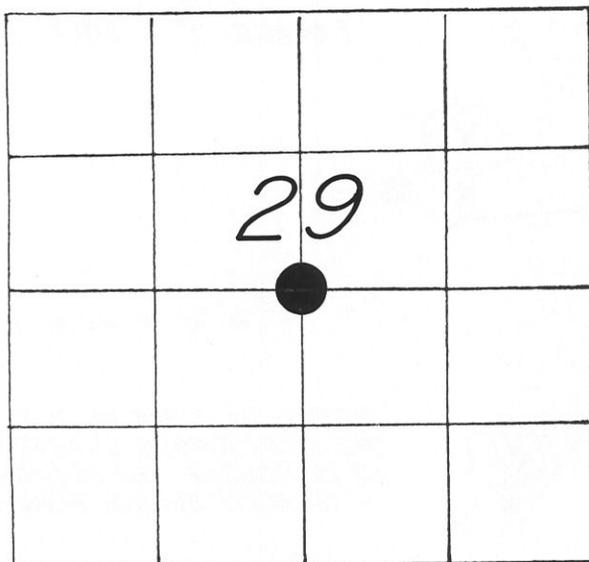

LOCATION OF LANDMARK

CREW: **BRYAN H. MEYER**  
**PETER F. FOLLANSBEE**  
DATE: 11/04/2010

WISCONSIN COORDINATE SYSTEM	
North	733,029.786
East	1,704,799.228
Theta Angle	
Horiz. Order	
Vert. Order	
DATUM:	1983 ('91)
TYPE OF LANDMARK	
3/4" IRON BAR.	
BEARINGS ARE REFERENCED TO	

Describe any record evidence, monument evidence, testimonial evidence or any other material evidence you considered and whether the monument was found or restored through acceptance of an obliterated evidence location.


Describe or show any material discrepancy between the location of the restored corner and that of the corner previously restored or reestablished.

**NONE KNOWN.**

RECORD OF DURABLE WITNESS MONUMENTS  
MAGNETIC

NO	DESCRIPTION	BEARING	DISTANCE
1	SET A NAIL IN N.-ERLY SIDE OF A 5-1/2" HICKORY	S 64° W	5.87 FT.
2	SET A NAIL IN N.-ERLY SIDE OF AN 18-1/2" BL. OAK	S 86° E	28.12 FT.
3	SET A NAIL IN S.-ERLY SIDE OF A 4-1/2" HICKORY	S 40° E	10.98 FT.
4	SET A NAIL IN S.-WEST SIDE OF A 17" BL. OAK	S 35° E	40.98 FT.

(SCALE: 1" = 20')

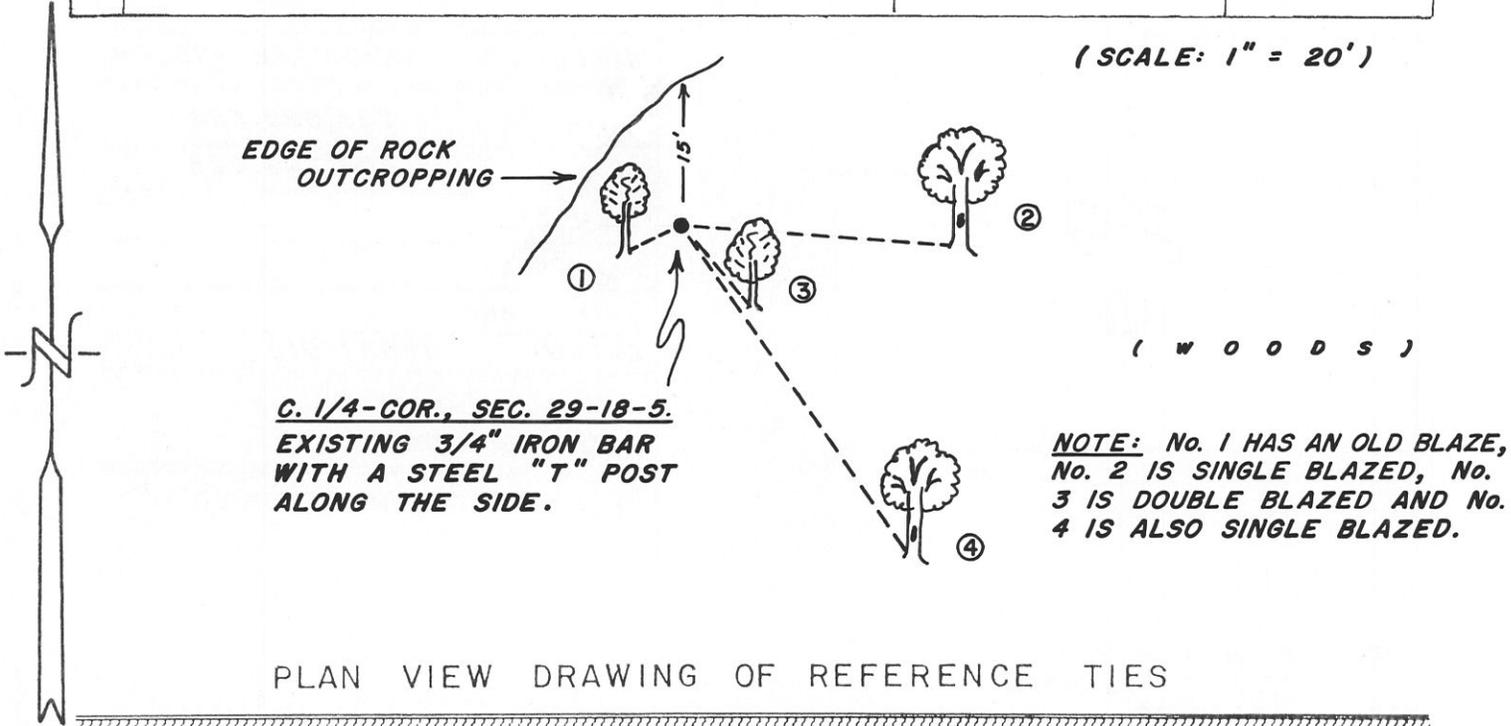

MAP SHOWING DISTANCE AND DIRECTION TO OTHER PUBLIC LAND SURVEY CORNERS USED FOR REESTABLISHING THE CORNER

I, BRYAN H. MEYER, LA CROSSE COUNTY SURVEYOR  
HEREBY CERTIFY THAT THE CORNER LOCATION SHOWN ON THIS RECORD  
WAS DETERMINED BY ME OR UNDER MY DIRECTION AND CONTROL AND  
THAT THIS U. S. PUBLIC LAND SURVEY MONUMENT RECORD IS CORRECT  
AND COMPLETE TO THE BEST OF MY KNOWLEDGE AND BELIEF.

*Bryan H. Meyer*  
Signature

12/10/2010  
Date



Seal