


21805300020

U. S. PUBLIC LAND SURVEY MONUMENT RECORD

SECTION 31 T 18 N, R 5 W, TOWN OF FARMINGTON

LA CROSSE COUNTY

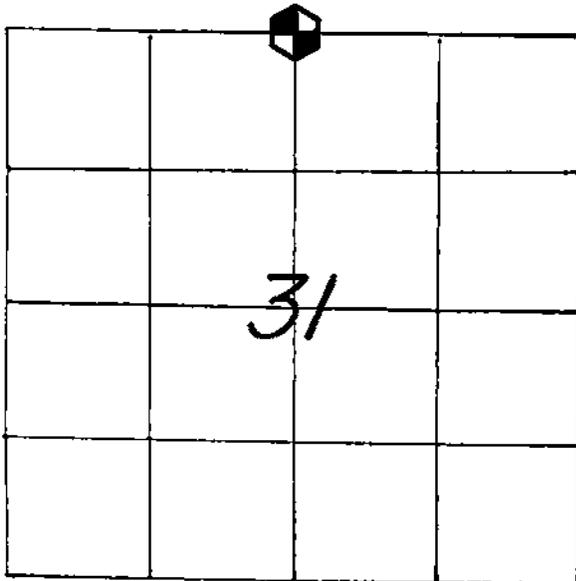

LOCATION OF LANDMARK

CREW: WILLIAM G. JUNG
 PETER F. FOLLANSBEE
 DATE: 9/14/2006

WISCONSIN COORDINATE SYSTEM

North

East

Theta Angle

Horiz. Order

Vert. Order

TYPE OF LANDMARK

BRASS CAP LUNDE MARKER.

BEARINGS ARE REFERENCED TO

**LACROSSE COUNTY COORDINATE SYSTEM
 NORTH AS PER SECTION DATA.**

Describe any record evidence, monument evidence, testimonial evidence or any other material evidence you considered and whether the monument was found or restored through acceptance of an obliterated evidence location.

Mr. Hemp called and complained that this corner had been bulldozed out. Apparently the operator was working for the landowner to the northwest. Mr. Horstman told me that he thought that this was an accident. I reset the corner at the 1995 position. Of six bearing trees from 1995, only one was still standing!


Describe or show any material discrepancy between the location of the restored corner and that of the corner previously restored or reestablished.

NONE KNOWN.

U. S. PUBLIC LAND SURVEY MONUMENT RECORD

SECTION 31 T 18 N, R 5 W, TOWN OF FARMINGTON

LA CROSSE COUNTY

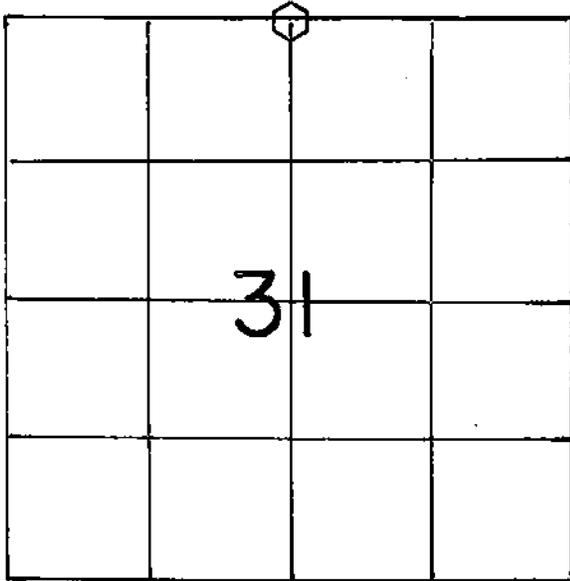

LOCATION OF LANDMARK

WISCONSIN COORDINATE SYSTEM

North

East

Theta Angle

Horiz. Order

Vert. Order

TYPE OF LANDMARK

Brass cap Lunde marker.

BEARINGS ARE REFERENCED TO

Crew: WILLIAM C. JUNG
 PETER F. FOLLANSBEE
 Date: 5/16/1995

Describe any record evidence, monument evidence, testimonial evidence or any other material evidence you considered and whether the monument was found or restored through acceptance of an obliterated evidence location.

I found an iron pipe at the corner which had been used in previous survey work. I've accepted this pipe as the best available evidence of the original corner position, removed it, and replaced it with a brass capped Lunde marker. The location also fits the occupied location.


Describe or show any material discrepancy between the location of the restored corner and that of the corner previously restored or reestablished.

None Known.

RECORD OF DURABLE WITNESS MONUMENTS

NO	DESCRIPTION	MAGNETIC	
		BEARING	DISTANCE
1	Set P.K. Nail in NW-side 6" Hickory (unblazed)	S 42° W	62.16 Ft.
2	Set P.K. Nail in SE-side 14" double W. Oak	N 14° E	28.10 Ft.
3	Set P.K. Nail in SE-side 27" Oak (original)?	N 22° E	50.86 Ft.
4	Set P.K. Nail in S.-side 15" W. Oak	N 74° E	27.67 Ft.

⑤ = 22" HICKORY WITH OLD SINGLE BLAZE (N 64° E, 22.45')
 ⑥ = 12" W. OAK (DYING) W/EX. SINGLE BLAZE (EAST ±, 38.34')
 (To center of trees)

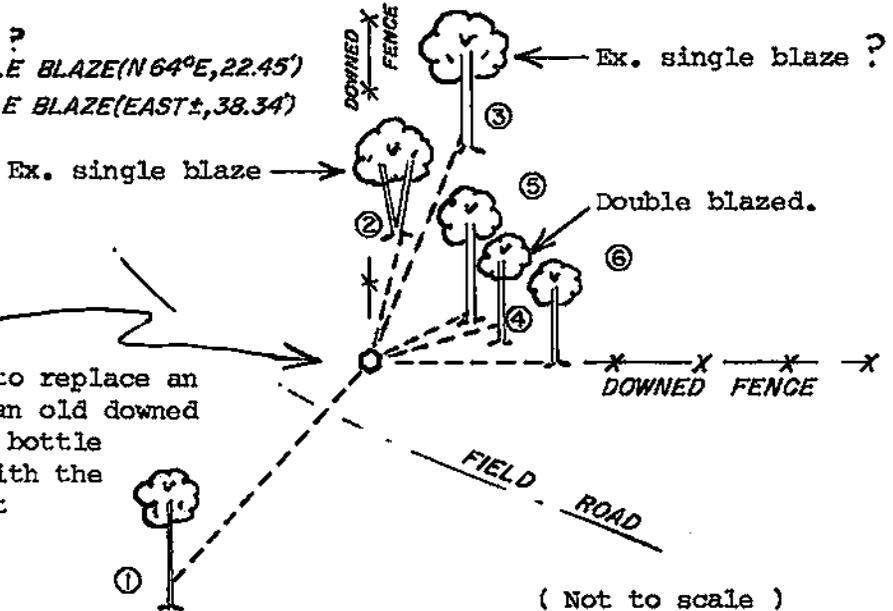

N. 1/4-Cor., Sec. 31-18-5.
 Set brass cap Lunde marker to replace an existing bent iron pipe by an old downed fence corner post. Buried a bottle containing a shell casing with the marker and set a sign & post nearby.

PLAN VIEW DRAWING OF REFERENCE TIES

MAP SHOWING DISTANCE AND DIRECTION TO OTHER PUBLIC LAND SURVEY CORNERS USED FOR REESTABLISHING THE CORNER

No section measurements were made at this time. The position of this corner was verified by previous survey work.

I, William C. Jung, County Surveyor
 HEREBY CERTIFY THAT THE CORNER LOCATION SHOWN ON THIS RECORD WAS DETERMINED BY ME OR UNDER MY DIRECTION AND CONTROL AND THAT THIS U. S. PUBLIC LAND SURVEY MONUMENT RECORD IS CORRECT AND COMPLETE TO THE BEST OF MY KNOWLEDGE AND BELIEF.

William C. Jung 8/17/95
 Signature Date



Seal