


21805302000

U. S. PUBLIC LAND SURVEY MONUMENT RECORD

SECTION 30 T 18 N, R 5 W, TOWN OF FARMINGTON

LA CROSSE COUNTY

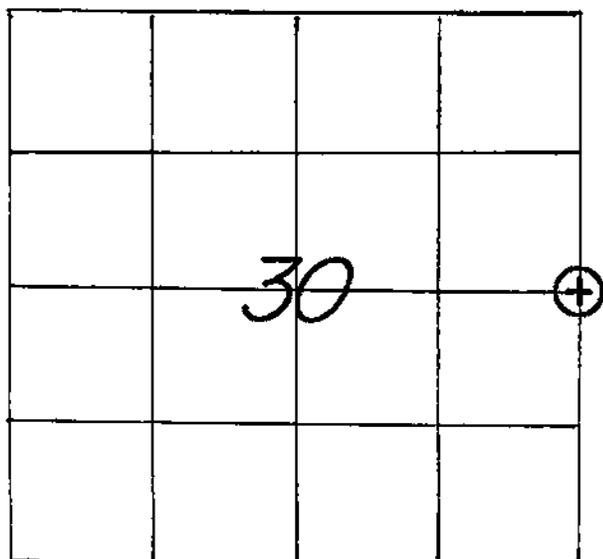

WISCONSIN COORDINATE SYSTEM

North

East

Theta Angle

Horiz. Order

Vert. Order

TYPE OF LANDMARK

1" IRON PIPE WITH AN ALUMINUM CAP.

BEARINGS ARE REFERENCED TO

LOCATION OF LANDMARK

CREW: WILLIAM C. JUNG
 PETER F. FOLLANSBEE
 DATE: 11/05/2004

Describe any record evidence, monument evidence, testimonial evidence or any other material evidence you considered and whether the monument was found or restored through acceptance of an obliterated evidence location.


I found an iron pipe at the old occupied corner. This pipe had been used as the corner in previous surveys. I accepted the pipe as the best available evidence of the original government corner position. A Berntsen cap was put on the pipe. A sign and post were set nearby. Also, there is a steel fence post by the corner.

Describe or show any material discrepancy between the location of the restored corner and that of the corner previously restored or reestablished.

NONE KNOWN.


RECORD OF DURABLE WITNESS MONUMENTS

NO	DESCRIPTION	MAGNETIC	
		BEARING	DISTANCE
1	SET A 3/4" x 30" IRON BAR, FLUSH	NORTH ±	15.56 FT.
2	SET A NAIL IN S.W.-SIDE OF A 6-1/2" OAK	S 14° E	33.38 FT.
3	SET A NAIL IN N.W.-SIDE OF A 12-1/8" ELM	S 36° W	18.94 FT.
4	SET A NAIL IN S.W.-SIDE OF A 7" HICKORY	N 66° W	23.44 FT.

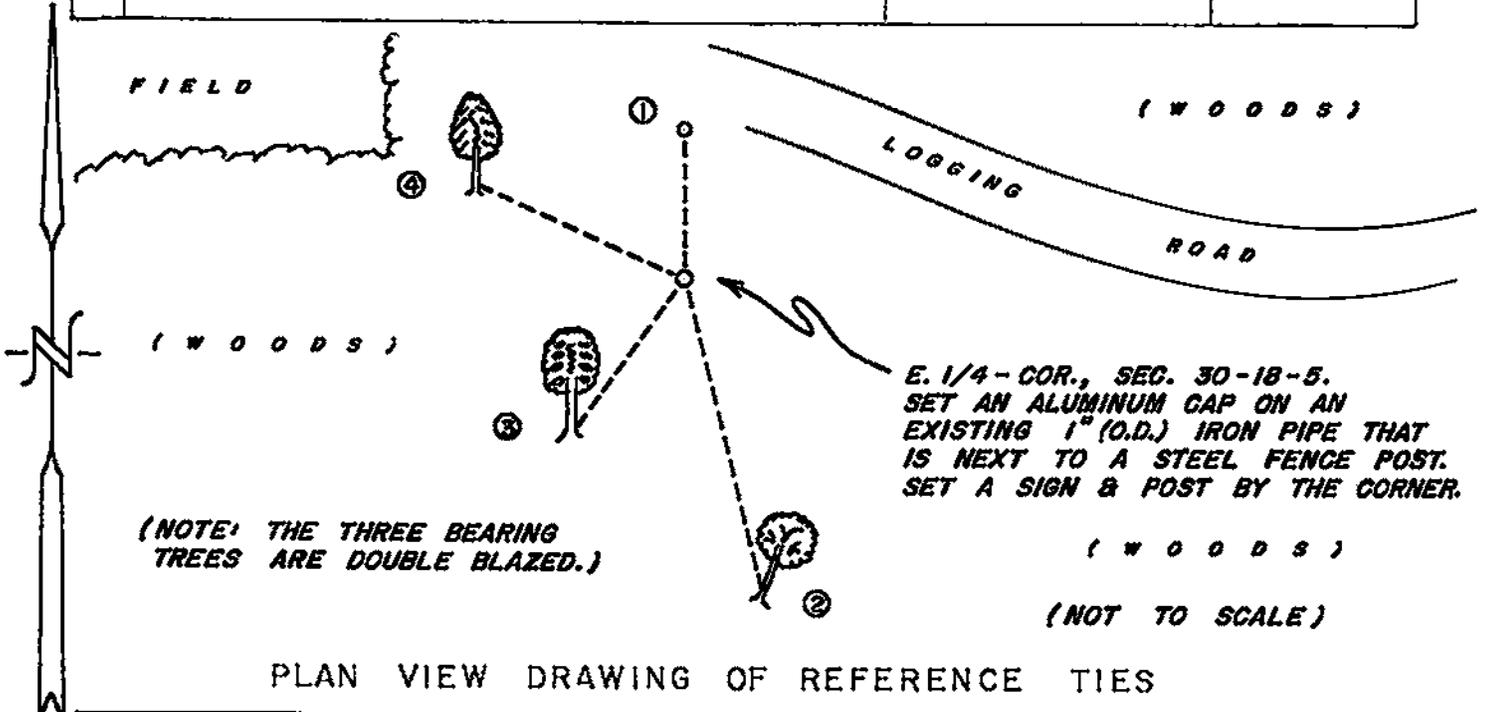

MAP SHOWING DISTANCE AND DIRECTION TO OTHER PUBLIC LAND SURVEY CORNERS USED FOR REESTABLISHING THE CORNER


(not to scale)

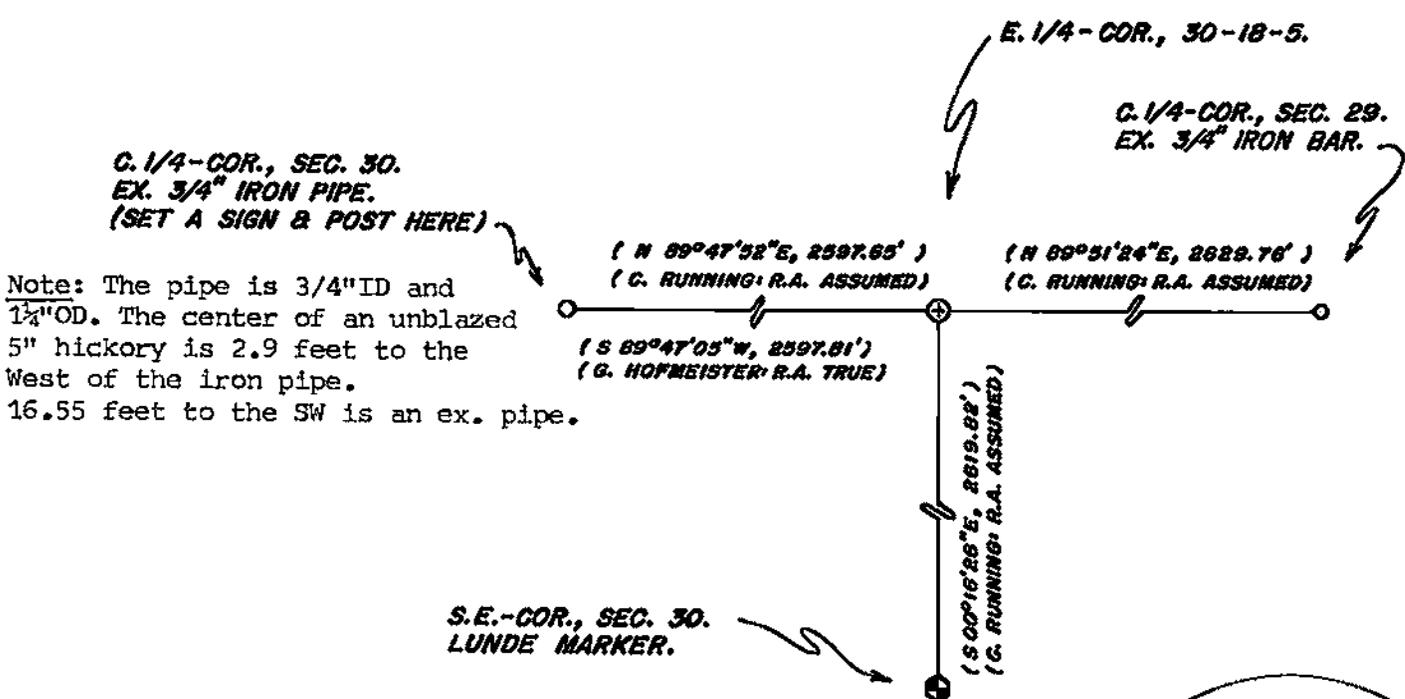

I, WILLIAM C. JUNG, COUNTY SURVEYOR
HEREBY CERTIFY THAT THE CORNER LOCATION SHOWN ON THIS RECORD WAS DETERMINED BY ME OR UNDER MY DIRECTION AND CONTROL AND THAT THIS U. S. PUBLIC LAND SURVEY MONUMENT RECORD IS CORRECT AND COMPLETE TO THE BEST OF MY KNOWLEDGE AND BELIEF.

William C. Jung
Signature

12/22/04
Date

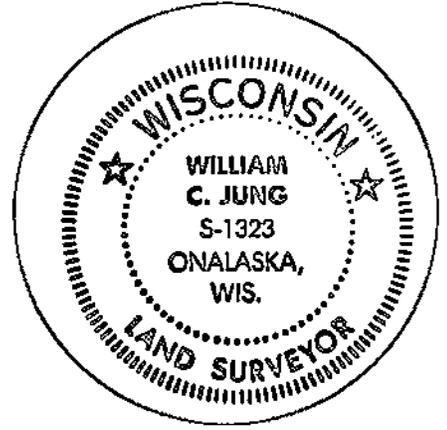

Seal