


21805310020

U. S. PUBLIC LAND SURVEY MONUMENT RECORD

SECTION 31 T 18 N, R 5 W, TOWN OF Farmington

LA CROSSE COUNTY

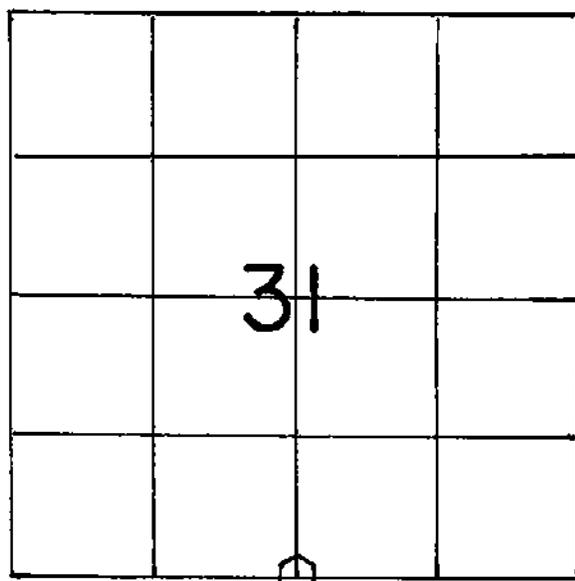

LOCATION OF LANDMARK

Crew: WILLIAM C. JUNG
 PETER F. FOLLANSBEE
 Date: 5/05/1995

WISCONSIN COORDINATE SYSTEM

North

East

Theta Angle

Horiz. Order

Vert. Order

TYPE OF LANDMARK

Brass capped Lunde marker

BEARINGS ARE REFERENCED TO

Describe any record evidence, monument evidence, testimonial evidence or any other material evidence you considered and whether the monument was found or restored through acceptance of an obliterated evidence location.

Greg Hofmeister set an iron pipe at this corner in 1981. We could not find an iron pipe at the corner. We set a Lunde marker at Hofmeister's location after retracing his survey in Section 31.

Describe or show any material discrepancy between the location of the restored corner and that of the corner previously restored or reestablished.

None known.

