


## U. S. PUBLIC LAND SURVEY MONUMENT RECORD

SECTION 31 T 18 N, R 5 W, TOWN OF FARMINGTON

LA CROSSE COUNTY

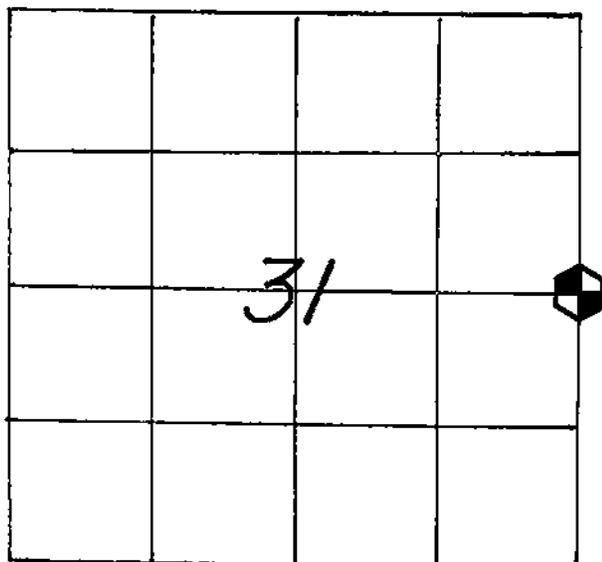

LOCATION OF LANDMARK

CREW: WILLIAM C. JUNG  
 PETER F. FOLLANSBEE  
 DATE: 5/05/2004

## WISCONSIN COORDINATE SYSTEM

North

East

Theta Angle

Horiz. Order

Vert. Order

## TYPE OF LANDMARK

**BRASS CAP LUNDE MARKER.**

BEARINGS ARE REFERENCED TO

Describe any record evidence, monument evidence, testimonial evidence or any other material evidence you considered and whether the monument was found or restored through acceptance of an obliterated evidence location.


Mike Harding and I agreed that the old occupied fence corner was the best available evidence of the original government corner position. I removed Harding's nail and replaced it with a brass capped Lunde marker.

Describe or show any material discrepancy between the location of the restored corner and that of the corner previously restored or reestablished.

**NONE KNOWN.**

RECORD OF DURABLE WITNESS MONUMENTS

NO	DESCRIPTION	MAGNETIC	
		BEARING	DISTANCE
1	SET A NAIL IN S.W.-SIDE OF A 15" WHITE OAK	N 37° W	40.89 FT.
2	SET A NAIL IN N.E.-SIDE OF A 12" WHITE OAK	N 22° W	43.54 FT.
3	SET A NAIL IN W.-SIDE OF A 12" HICKORY	N 02° W	7.07 FT.
4	SET A NAIL IN N.W.-SIDE OF A 9-1/2" HICKORY	S 31° E	19.76 FT.

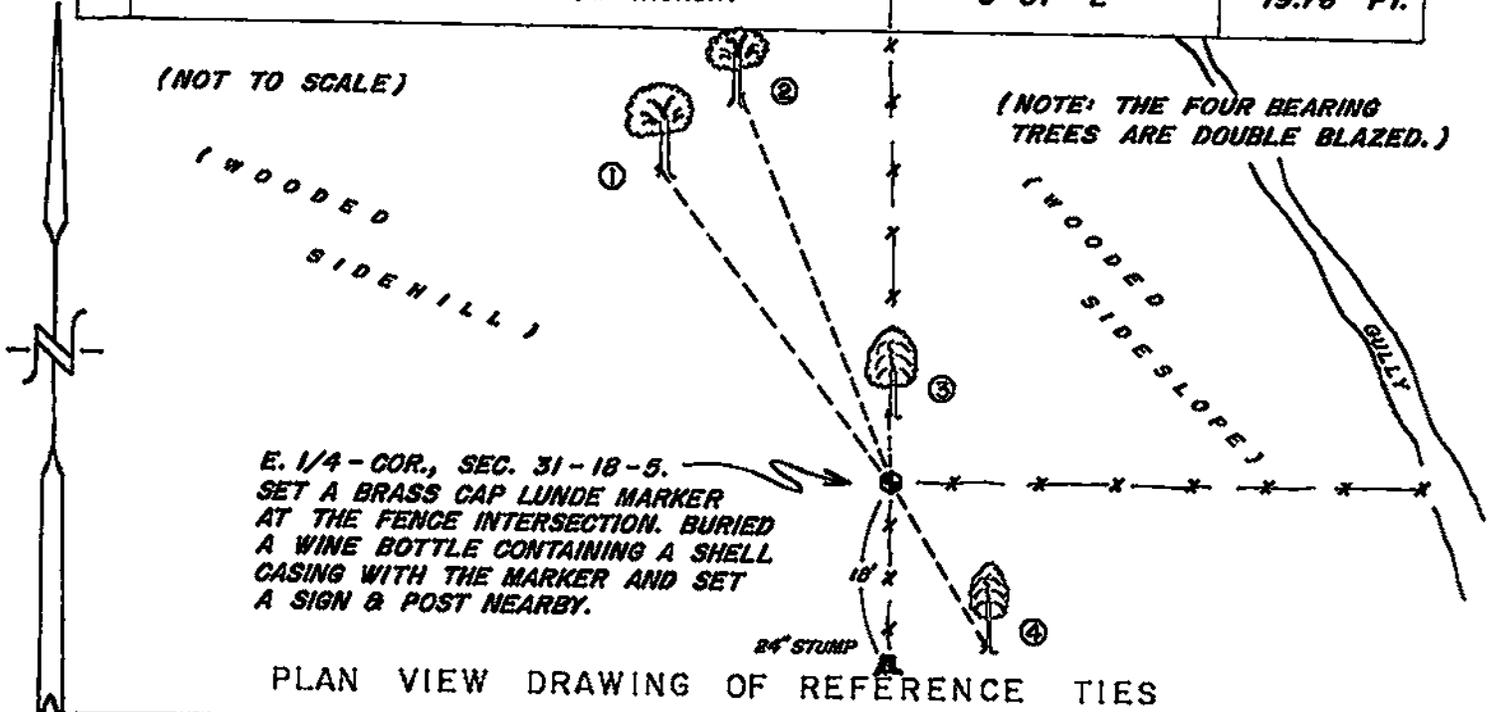

MAP SHOWING DISTANCE AND DIRECTION TO OTHER PUBLIC LAND SURVEY CORNERS USED FOR REESTABLISHING THE CORNER

No section measurements were made by me at this time. The location of this corner was confirmed by Harding's section measurements.

I, WILLIAM C. JUNG, COUNTY SURVEYOR  
 HEREBY CERTIFY THAT THE CORNER LOCATION SHOWN ON THIS RECORD  
 WAS DETERMINED BY ME OR UNDER MY DIRECTION AND CONTROL AND  
 THAT THIS U. S. PUBLIC LAND SURVEY MONUMENT RECORD IS CORRECT  
 AND COMPLETE TO THE BEST OF MY KNOWLEDGE AND BELIEF.

William C. Jung                      8/30/04  
 Signature                                      Date



Seal