


U. S. PUBLIC LAND SURVEY MONUMENT RECORD

SECTION 32 T 18 N, R 5 W, TOWN OF FARMINGTON
LA CROSSE COUNTY

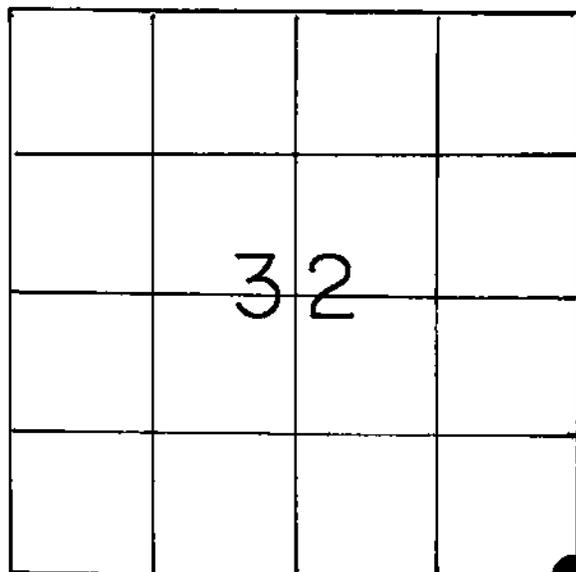

LOCATION OF LANDMARK

WISCONSIN COORDINATE SYSTEM

North

East

Theta Angle

Horiz. Order

Vert. Order

TYPE OF LANDMARK

1" iron pipe ***

BEARINGS ARE REFERENCED TO

Assumed

Crew: William C. Jung

Peter F. Follansbee

Date: 3/10/88 & 5/20/88

Describe any record evidence, monument evidence, testimonial evidence or any other material evidence you considered and whether the monument was found or restored through acceptance of an obliterated evidence location.

I projected the old fence along the South line of the SE1/4 East and intersected it with the old fence to the South projected North. I accepted the occupied conditions as the best available evidence of the original government corner. This fits the evidence to the North and West very well.

Describe or show any material discrepancy between the location of the restored corner and that of the corner previously restored or reestablished.

None known.

*** Revised: August 5, 1988

On 5/20/88 I replaced the iron pipe with a brass capped Lunde marker. *weg*

