


## U. S. PUBLIC LAND SURVEY MONUMENT RECORD

SECTION 32 T 18 N, R 5 W, TOWN OF FARMINGTON  
 LA CROSSE COUNTY

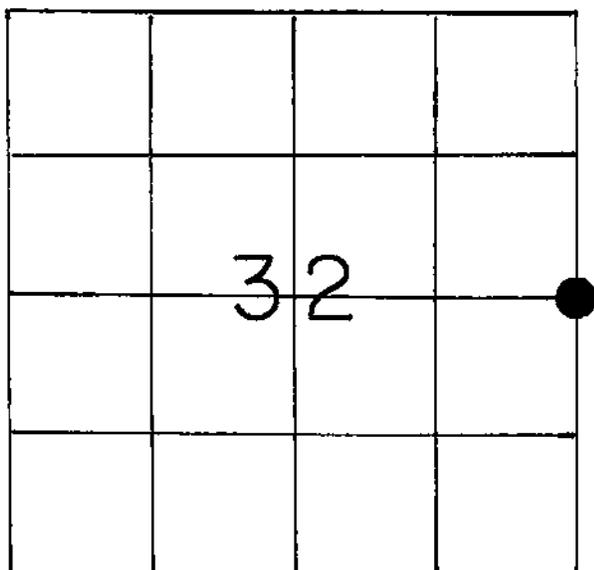

LOCATION OF LANDMARK

Crew: William C. Jung

Peter F. Follansbee

Date: 3/10/88 & 5/20/88

Describe any record evidence, monument evidence, testimonial evidence or any other material evidence you considered and whether the monument was found or restored through acceptance of an obliterated evidence location.

I projected the fence along the North line of the SE1/4 East and intersected it with the old line fence to the South. This also fits the old fence coming from the East fairly well too, within 2'. With this corner set as such, and the SE Corner set so as to fit the occupation, the E1/16SE Corner falls in an old East-West fence. I accepted the old fences and occupation near the East 1/4 Corner as the best available evidence of old lines "surveyed and run".

Describe or show any material discrepancy between the location of the restored corner and that of the corner previously restored or reestablished.

None known.

\*\*\* Revised: August 5, 1988

On 5/20/88 I replaced the P.K. nail  
 with a brass capped Lunde marker.

wey

## WISCONSIN COORDINATE SYSTEM

North

East

Theta Angle

Horiz. Order

Vert. Order

## TYPE OF LANDMARK

P.K. nail \*\*\*

## BEARINGS ARE REFERENCED TO

Assumed

RECORD OF DURABLE WITNESS MONUMENTS

NO	DESCRIPTION	MAGNETIC	
		BEARING	DISTANCE
1	P.K. nail in double blazed 14" white oak	N86°E	44.48
2	P.K. nail in double blazed 10" aspen	S67°E	43.70
3	P.K. nail in double blazed 8" hickory	S49°E	48.30
4	1" iron pipe on the side of a 10" cherry	S 4°E	82.52



5/20/88 - now a brass capped Lunde marker


Set a P.K. nail at the final corner, 2.19 feet South of my nail and cap survey point and 6' N.W. of the road centerline.

Centerline of Herman Coulee Road

PLAN VIEW DRAWING OF REFERENCE TIES

MAP SHOWING DISTANCE AND DIRECTION TO OTHER PUBLIC LAND SURVEY CORNERS USED FOR REESTABLISHING THE CORNER


(not to scale)

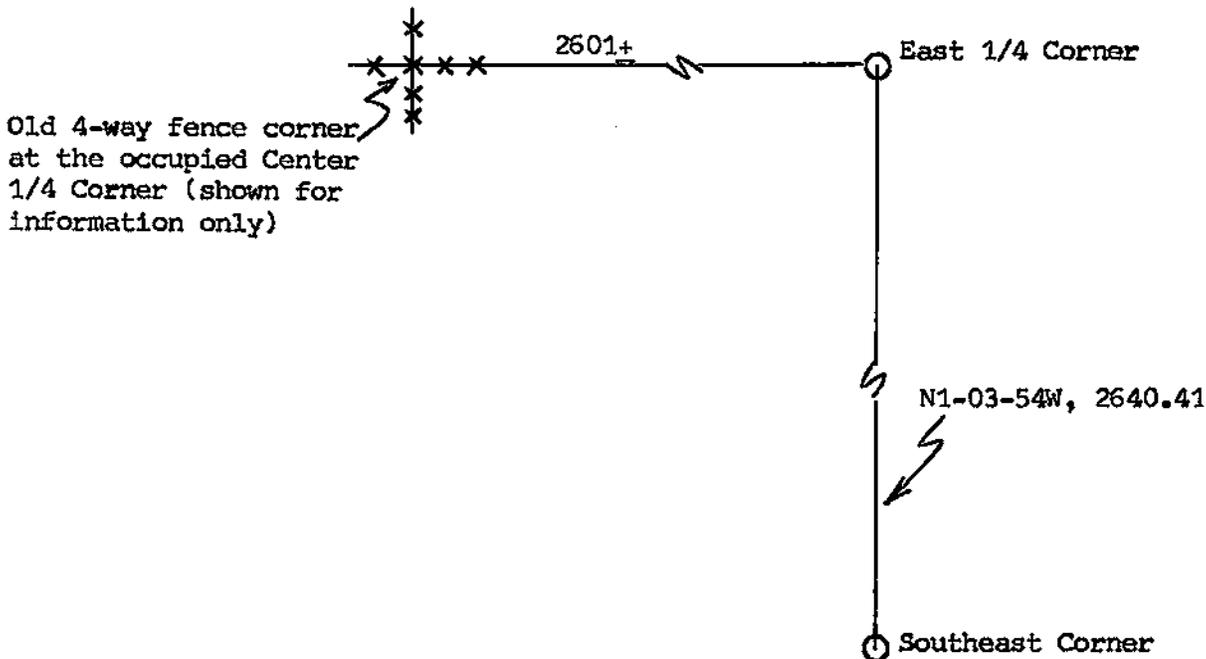

I, William C. Jung, Deputy County Surveyor  
 HEREBY CERTIFY THAT THE CORNER LOCATION SHOWN ON THIS RECORD  
 WAS DETERMINED BY ME OR UNDER MY DIRECTION AND CONTROL AND  
 THAT THIS U. S. PUBLIC LAND SURVEY MONUMENT RECORD IS CORRECT  
 AND COMPLETE TO THE BEST OF MY KNOWLEDGE AND BELIEF.

*William C. Jung*  
 Signature

March 28, 1988  
 Date

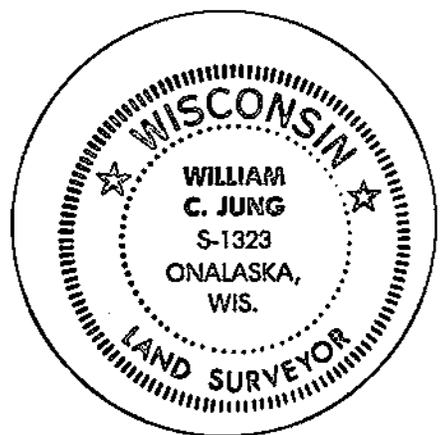

Seal