


21805330000

U. S. PUBLIC LAND SURVEY MONUMENT RECORD

SECTION 34 T 18 N, R 5 W, TOWN OF BURNS

LA CROSSE COUNTY

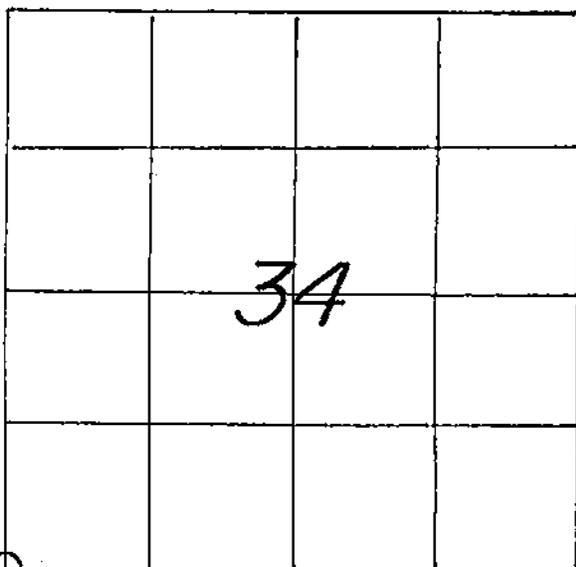

LOCATION OF LANDMARK

CREW: WILLIAM C. JUNG
PETER F. FOLLANSBEE
DATE: 4/27/00

WISCONSIN COORDINATE SYSTEM

North 725,101.912

East 1,712,618.450

Theta Angle

Horiz. Order

Vert. Order

DATUM: 83 ('91)

TYPE OF LANDMARK

1 1/2"x24" iron pipe, down 16" in a field

BEARINGS ARE REFERENCED TO

GRID NORTH AS PER SECTION DATA.

Describe any record evidence, monument evidence, testimonial evidence or any other material evidence you considered and whether the monument was found or restored through acceptance of an obliterated evidence location.


This corner, being lost, was set "by law" using single proportionate measurement.

Describe or show any material discrepancy between the location of the restored corner and that of the corner previously restored or reestablished.


None known.

RECORD OF DURABLE WITNESS MONUMENTS

NO	DESCRIPTION	GRID NORTH	GRID DIST.'s
		BEARING	DISTANCE
1	SET A R.K. NAIL IN S-SIDE 21" OAK	N 83°13'46" W	255.86 FT.
2	SET R.K. NAIL IN S.W.-SIDE OF S.E.-TRUNK, HICKORY CLUSTER	N 20°37'52" E	199.34 FT.
3	SET A R.K. NAIL IN N.-SIDE 16" HICKORY	S 64°38'40" E	171.23 FT.
4	SET A R.K. NAIL IN W.-SIDE 9" WHITE OAK	S 06°16'24" W	434.45 FT.

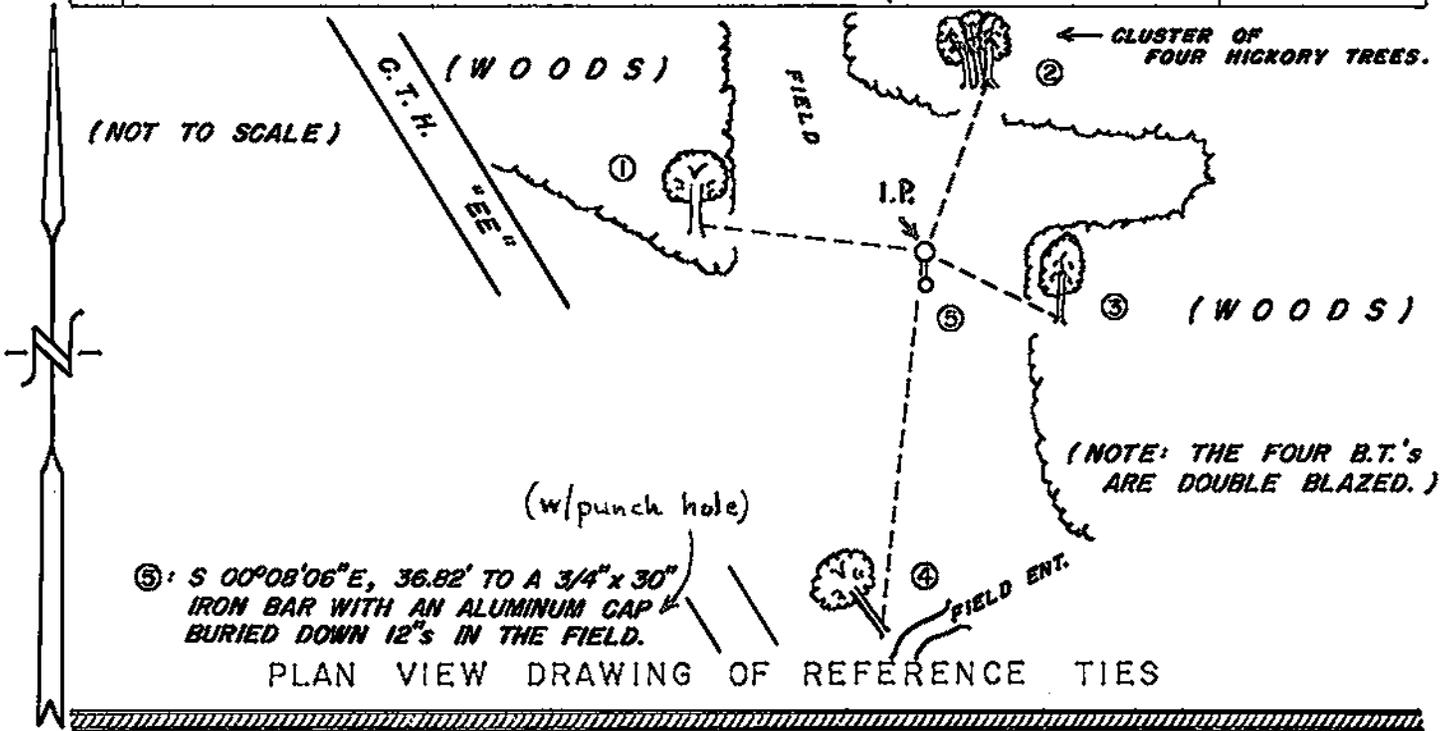

MAP SHOWING DISTANCE AND DIRECTION TO OTHER PUBLIC LAND SURVEY CORNERS USED FOR REESTABLISHING THE CORNER

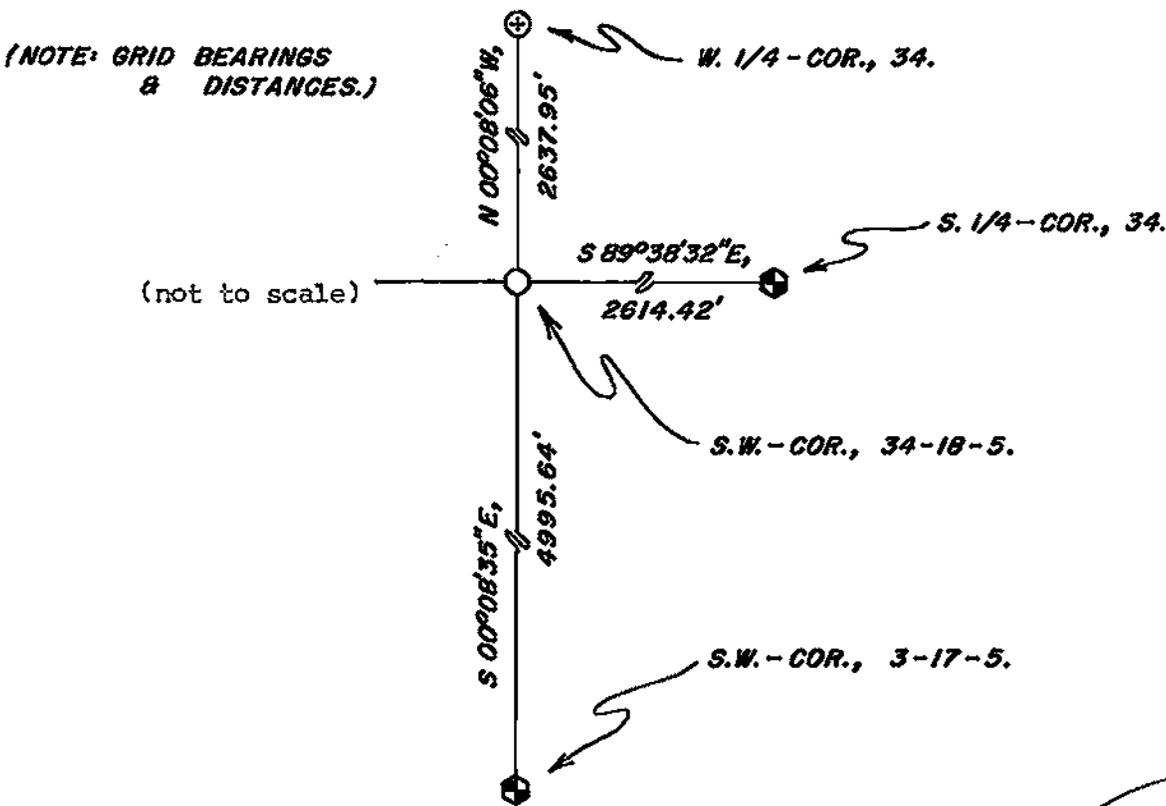

I, WILLIAM C. JUNG, COUNTY SURVEYOR
 HEREBY CERTIFY THAT THE CORNER LOCATION SHOWN ON THIS RECORD
 WAS DETERMINED BY ME OR UNDER MY DIRECTION AND CONTROL AND
 THAT THIS U. S. PUBLIC LAND SURVEY MONUMENT RECORD IS CORRECT
 AND COMPLETE TO THE BEST OF MY KNOWLEDGE AND BELIEF.

William C. Jung 5/18/00
 Signature Date



Seal