


21805330020

U. S. PUBLIC LAND SURVEY MONUMENT RECORD

SECTION 33 T 18 N, R 5 W, TOWN OF FARMINGTON
LA CROSSE COUNTY

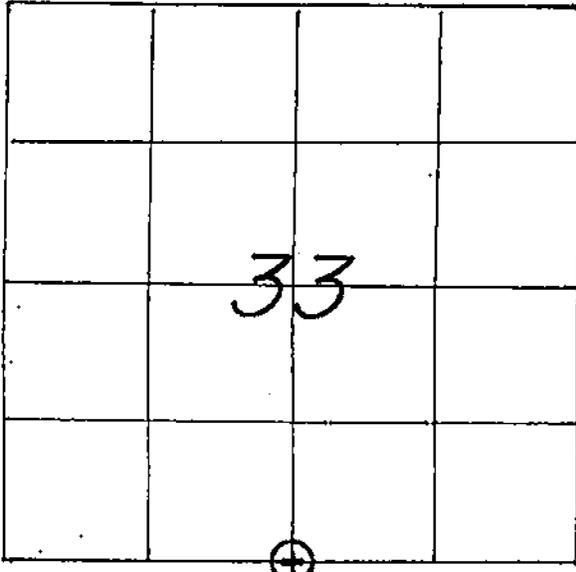

LOCATION OF LANDMARK

CREW: **WILLIAM C. JUNG**
PETER F. FOLLANSBEE
DATE: **12/16 /1999**

WISCONSIN COORDINATE SYSTEM

North

East

Theta Angle

Horiz. Order

Vert. Order

TYPE OF LANDMARK

3/4" x 30" IRON BAR WITH AN ALUMINUM CAP.

BEARINGS ARE REFERENCED TO


Describe any record evidence, monument evidence, testimonial evidence or any other material evidence you considered and whether the monument was found or restored through acceptance of an obliterated evidence location.

We found an old downed and rotted fence post with very old North-South tie wire. The old landowners had obviously fenced North-South here. Going North was one type of steel fence post and going South was another type. Bill Brewer, an adjoining landowner, said that a previous owner had told him that this location was the corner. I also found that this fits the town line very well too. I accepted this old occupied fence corner as the best available evidence of the original government corner. Describe or show any material discrepancy between the location of the restored position. corner and that of the corner previously restored or reestablished.

NONE KNOWN.

RECORD OF DURABLE WITNESS MONUMENTS
MAGNETIC

NO	DESCRIPTION	BEARING	DISTANCE
1	SET A NAIL IN S.W.-SIDE 14" OAK	S 28° E	19.98 FT.
2	SET A P.K. NAIL IN S.W.-SIDE 8" HICKORY (17.13' FROM ①)	S 28° E	37.11 FT.±
3	SET A NAIL IN N.W.-SIDE 7-1/2" OAK	S 17° E	46.43 FT.
4	SET A NAIL IN S.W.-SIDE 9-1/2" WHITE OAK	S 07° E	SLOPE=58.68'

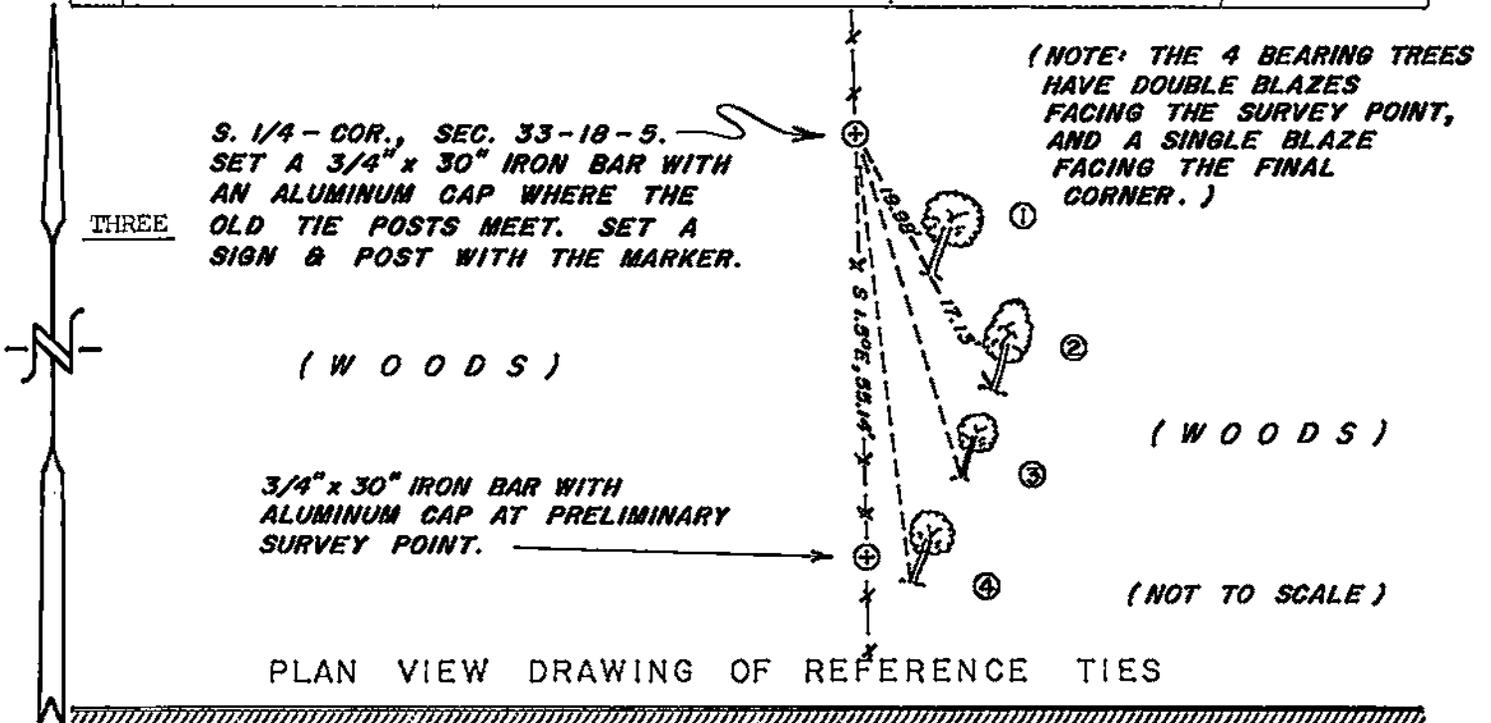


MAP SHOWING DISTANCE AND DIRECTION TO OTHER PUBLIC LAND SURVEY CORNERS USED FOR REESTABLISHING THE CORNER

At this time I made enough measurements to verify the correct location of this corner.

I, WILLIAM C. JUNG, COUNTY SURVEYOR
HEREBY CERTIFY THAT THE CORNER LOCATION SHOWN ON THIS RECORD WAS DETERMINED BY ME OR UNDER MY DIRECTION AND CONTROL AND THAT THIS U. S. PUBLIC LAND SURVEY MONUMENT RECORD IS CORRECT AND COMPLETE TO THE BEST OF MY KNOWLEDGE AND BELIEF.

William C. Jung
Signature

December 31, 1999
Date

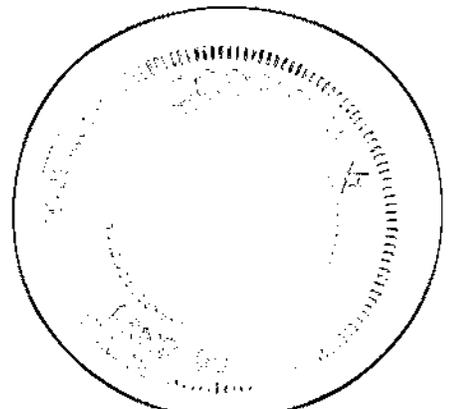

Seal