


21805332000

U. S. PUBLIC LAND SURVEY MONUMENT RECORD

SECTION 34 T 18 N, R 5 W, TOWN OF BURNS

LA CROSSE COUNTY

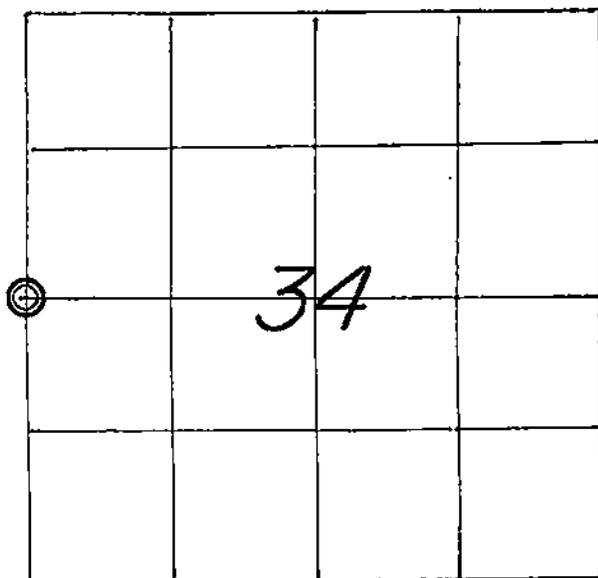

LOCATION OF LANDMARK

CREW: WILLIAM C. JUNG
 PETER F. FOLLANSBEE
 DATE: 11/05/1999

WISCONSIN COORDINATE SYSTEM

North 727,739.853

East 1,712,612.234

Theta Angle

Horiz. Order

Vert. Order

DATUM: 83('91)

TYPE OF LANDMARK

3/4" x 30" IRON BAR WITH AN ALUMINUM CAP

BEARINGS ARE REFERENCED TO

GRID NORTH AS PER SECTION DATA.

Describe any record evidence, monument evidence, testimonial evidence or any other material evidence you considered and whether the monument was found or restored through acceptance of an obliterated evidence location.


The corner was set on line between the section corners and on line with an "ancient" fence coming in from the West. The fence going to the East is "wild". ^{why} ~~The 1/2 mile to the South is long but the old occupied evidence supports this. The 1/2 mile to the South is probably long due to an error in the original "tally".~~ The corner was monumented with an iron bar and cap.

Describe or show any material discrepancy between the location of the restored corner and that of the corner previously restored or reestablished.

Randy Connell set the pipe 11.23 feet to the West of my corner and called it the 1/4 corner. I do not agree with it.

RECORD OF DURABLE WITNESS MONUMENTS
MAGNETIC


NO	DESCRIPTION	BEARING	DISTANCE
1	EXISTING LARGE IRON PIPE N.-WEST OF AN OLD STUMP	WEST ±	11.23 FT.
2	SET A P.K. NAIL IN S.E.-SIDE OF A DOUBLE HICKORY	S 62° W	23.71 FT.
3	SET A P.K. NAIL IN S.W.-SIDE OF A 9" HICKORY	S 15° E	15.27 FT.
4	SET A P.K. NAIL IN N.E.-SIDE OF A 12" HICKORY	S 69° E	SLOPE = 40.15'

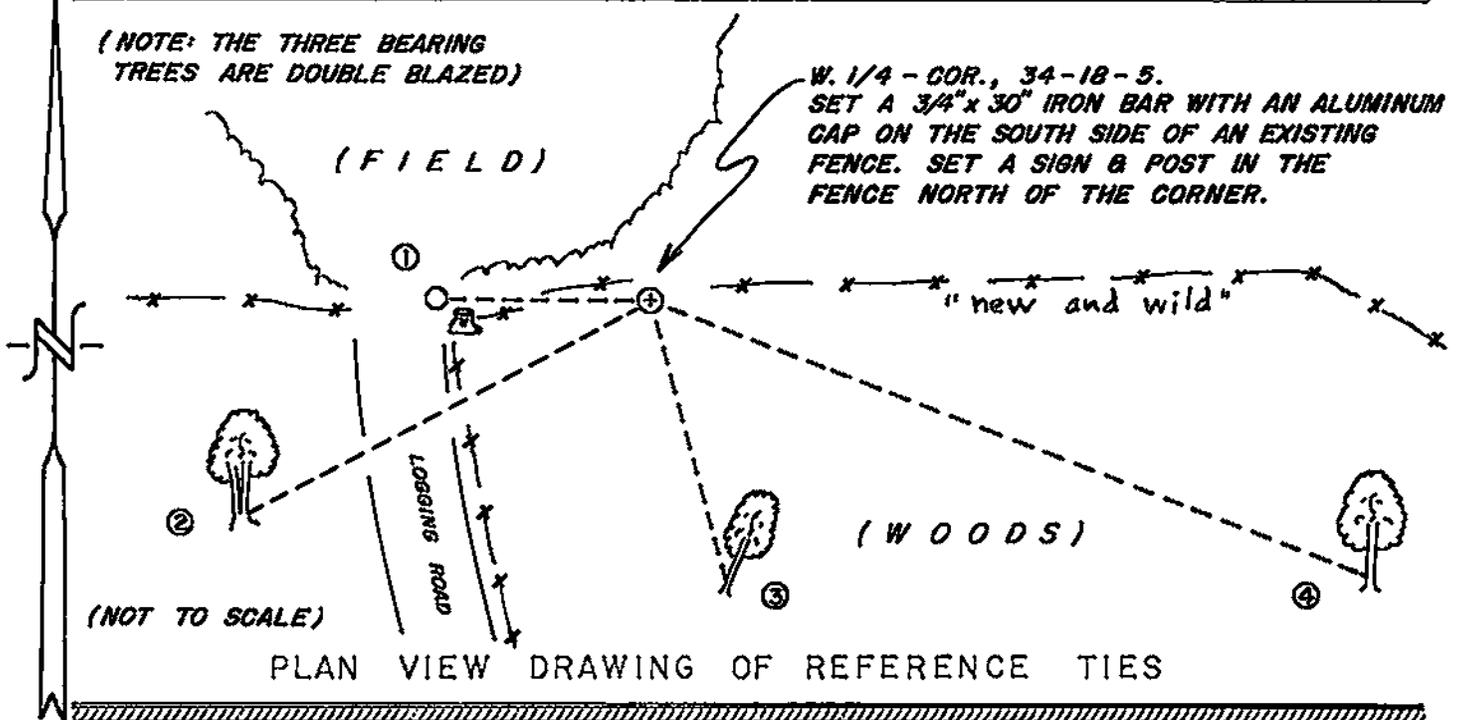

MAP SHOWING DISTANCE AND DIRECTION TO OTHER PUBLIC LAND SURVEY CORNERS USED FOR REESTABLISHING THE CORNER

(NOTE: GRID BEARINGS AND DISTANCES)

(not to scale)

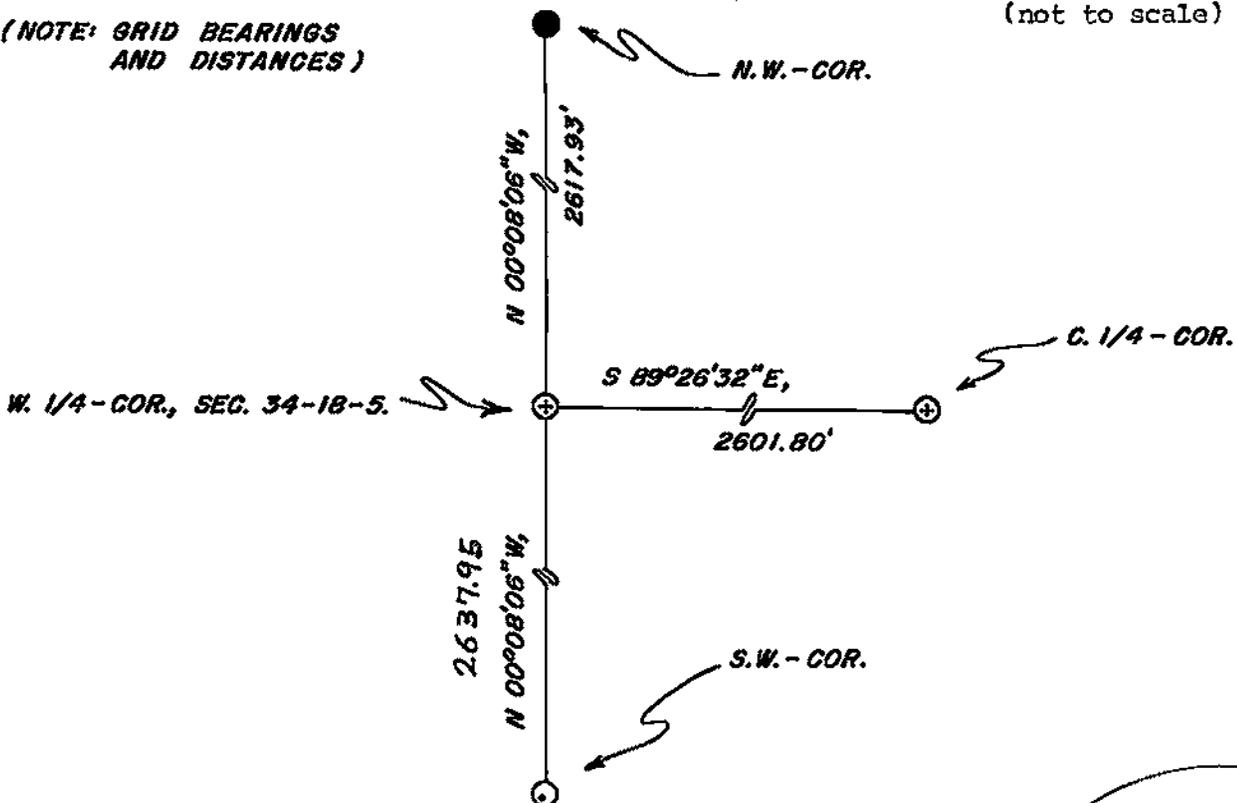


I, WILLIAM C. JUNG, COUNTY SURVEYOR
HEREBY CERTIFY THAT THE CORNER LOCATION SHOWN ON THIS RECORD WAS DETERMINED BY ME OR UNDER MY DIRECTION AND CONTROL AND THAT THIS U. S. PUBLIC LAND SURVEY MONUMENT RECORD IS CORRECT AND COMPLETE TO THE BEST OF MY KNOWLEDGE AND BELIEF.

William C. Jung
Signature

11/24/99

Date

Revised: 12/21/99 *wey*

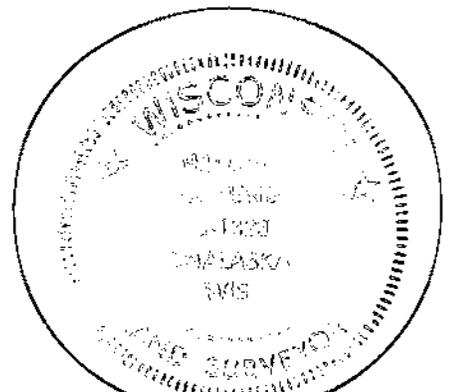

Seal