


21805340020 BU-251

U. S. PUBLIC LAND SURVEY MONUMENT RECORD

SECTION 34 T 18 N, R 5 W, TOWN OF BURNS

LA CROSSE COUNTY

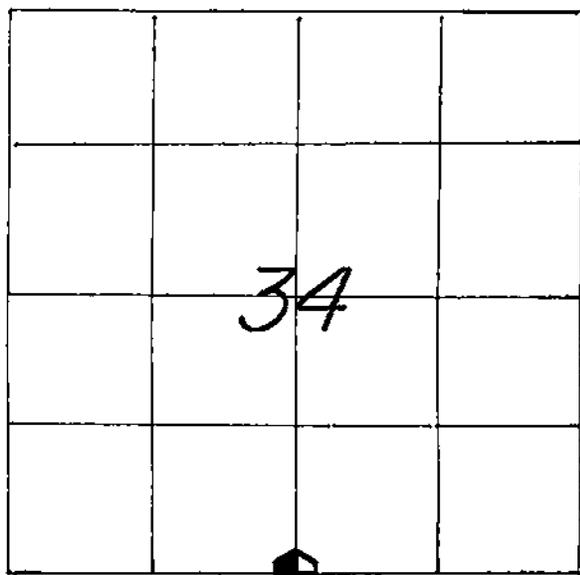

LOCATION OF LANDMARK

CREW: WILLIAM C. JUNG
 PETER F. FOLLANSBEE
 DATE: 5/03/2000

WISCONSIN COORDINATE SYSTEM	
North	725,085.581
East	1,715,232.815
Theta Angle	
Horiz. Order	
Vert. Order	
DATUM	83('91)
TYPE OF LANDMARK	
BRASS CAP LUNDE MARKER.	
BEARINGS ARE REFERENCED TO	
GRID NORTH AS PER SECTION DATA.	

Describe any record evidence, monument evidence, testimonial evidence or any other material evidence you considered and whether the monument was found or restored through acceptance of an obliterated evidence location.


We found buried by the new fence remnants of the old North-South line fence which fit the evidence along the North-South 1/4 line very well. I set the corner on line between the section corners and in this old fence. The corner was monumented with a brass capped Lunde marker.

Describe or show any material discrepancy between the location of the restored corner and that of the corner previously restored or reestablished.

NONE KNOWN.


RECORD OF DURABLE WITNESS MONUMENTS

NO	DESCRIPTION	BEARING	DISTANCE
1	SET A NAIL IN THE N.W.-SIDE OF A 5-1/4" OAK	S 55° W(MAG.)	22.43 FT.
2	SET A NAIL IN THE N.-SIDE OF A 13" OAK	S 51° W(MAG.)	37.00 FT.
3	SET A NAIL IN THE N.W.-SIDE OF A 19" OAK	S.'WESTERLY ±	39.70 FT.
4	SET A NAIL IN THE W.-SIDE OF A 5-1/4" OAK 20" E. OF FENCE	SOUTHERLY ±	3.90 FT.

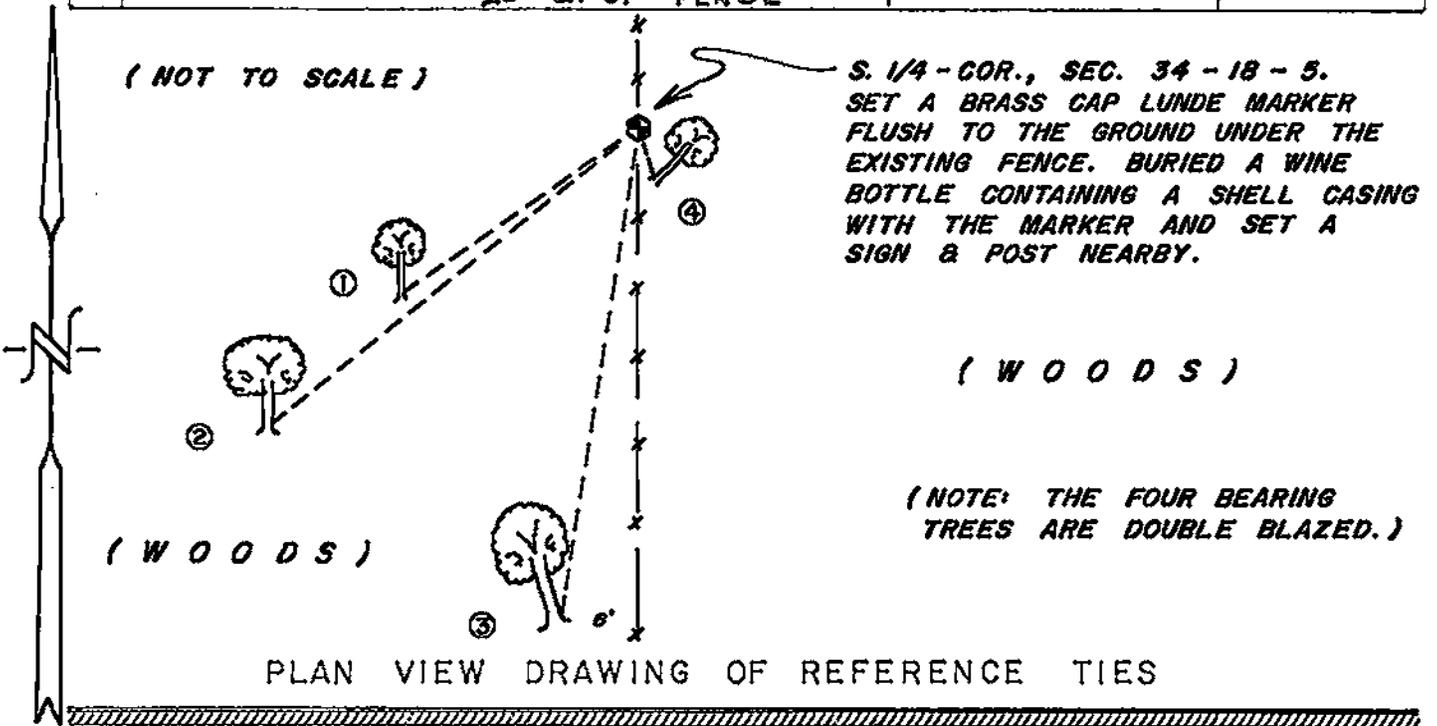

MAP SHOWING DISTANCE AND DIRECTION TO OTHER PUBLIC LAND SURVEY CORNERS USED FOR REESTABLISHING THE CORNER

Note: Grid bearings and distances (not to scale)

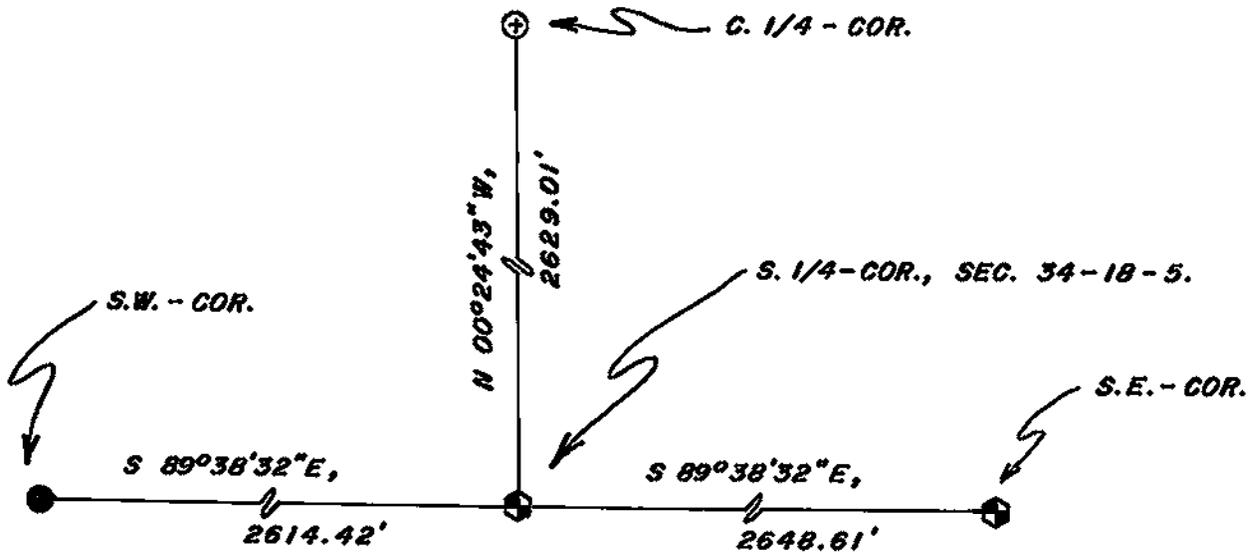

I, WILLIAM C. JUNG, COUNTY SURVEYOR
HEREBY CERTIFY THAT THE CORNER LOCATION SHOWN ON THIS RECORD
WAS DETERMINED BY ME OR UNDER MY DIRECTION AND CONTROL AND
THAT THIS U. S. PUBLIC LAND SURVEY MONUMENT RECORD IS CORRECT
AND COMPLETE TO THE BEST OF MY KNOWLEDGE AND BELIEF.

William C. Jung 5/18/00
Signature Date

