


21805342000

## U. S. PUBLIC LAND SURVEY MONUMENT RECORD

SECTION 34 T 18 N, R 5 W, TOWN OF BURNS

LA CROSSE COUNTY

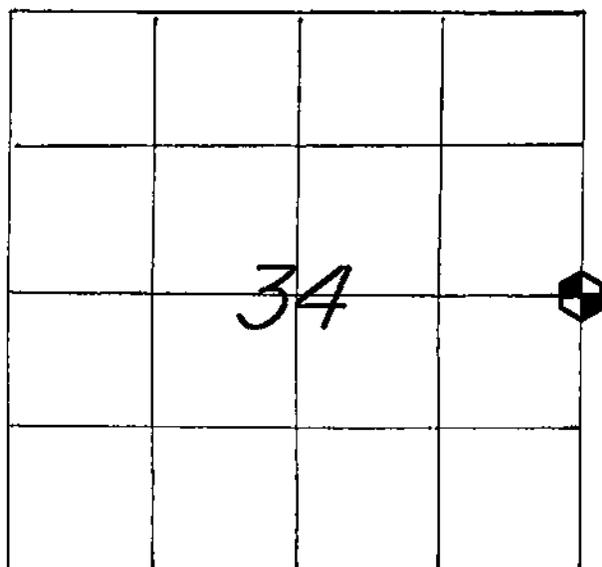

## WISCONSIN COORDINATE SYSTEM

North *727,688.915*East *1,717,844.750*

Theta Angle

Horiz. Order

Vert. Order

DATUM: *83('91)*

TYPE OF LANDMARK

*BRASS CAP LUNDE MARKER.*

BEARINGS ARE REFERENCED TO

*GRID NORTH AS PER SECTION DATA.*

## LOCATION OF LANDMARK

CREW: *WILLIAM C. JUNG*  
*PETER F. FOLLANSBEE*  
 DATE: *11/10/1999.*

Describe any record evidence, monument evidence, testimonial evidence or any other material evidence you considered and whether the monument was found or restored through acceptance of an obliterated evidence location.


This corner was set on line with the old line fence going to the North and equidistant between the section corners. This best fits the evidence that I found in Section 34. The corner was monumented with a brass capped Lunde marker.

Describe or show any material discrepancy between the location of the restored corner and that of the corner previously restored or reestablished.

*NONE KNOWN.*


RECORD OF DURABLE WITNESS MONUMENTS  
MAGNETIC

NO	DESCRIPTION	BEARING	DISTANCE
1	SET A 3/4" x 30" IRON BAR WITH AN ALUMINUM CAP	NORTH ±	25.88 FT.
2	SET A NAIL IN S.E.-SIDE 14" OAK	N 42° E	31.20 FT.
3	SET A NAIL IN N.W.-SIDE 10-1/2" WHITE OAK	S 21° W	SL = 17.37'
4	SET A NAIL IN N.-SIDE 14" OAK	S 80° W	34.16 FT.

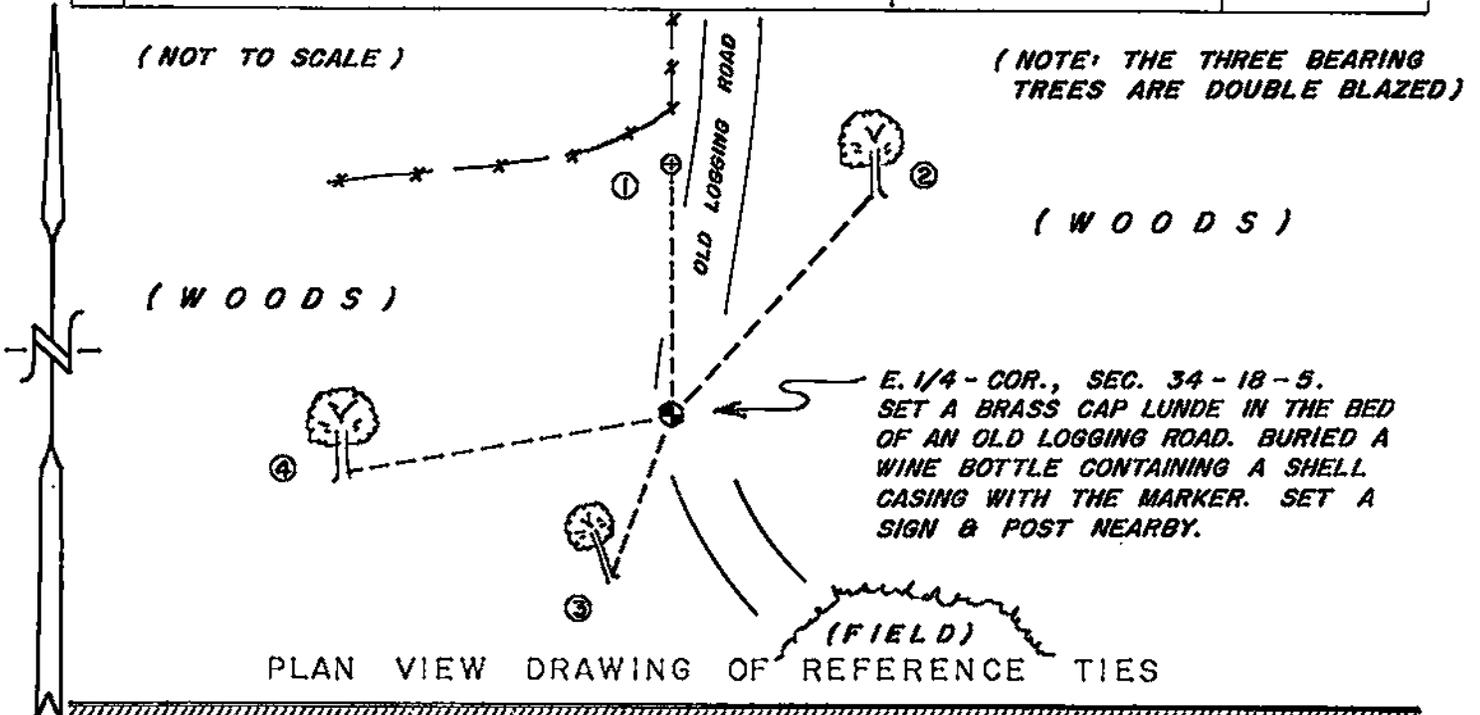

MAP SHOWING DISTANCE AND DIRECTION TO OTHER PUBLIC LAND SURVEY CORNERS USED FOR REESTABLISHING THE CORNER

(NOTE: GRID BEARINGS & DISTANCES)

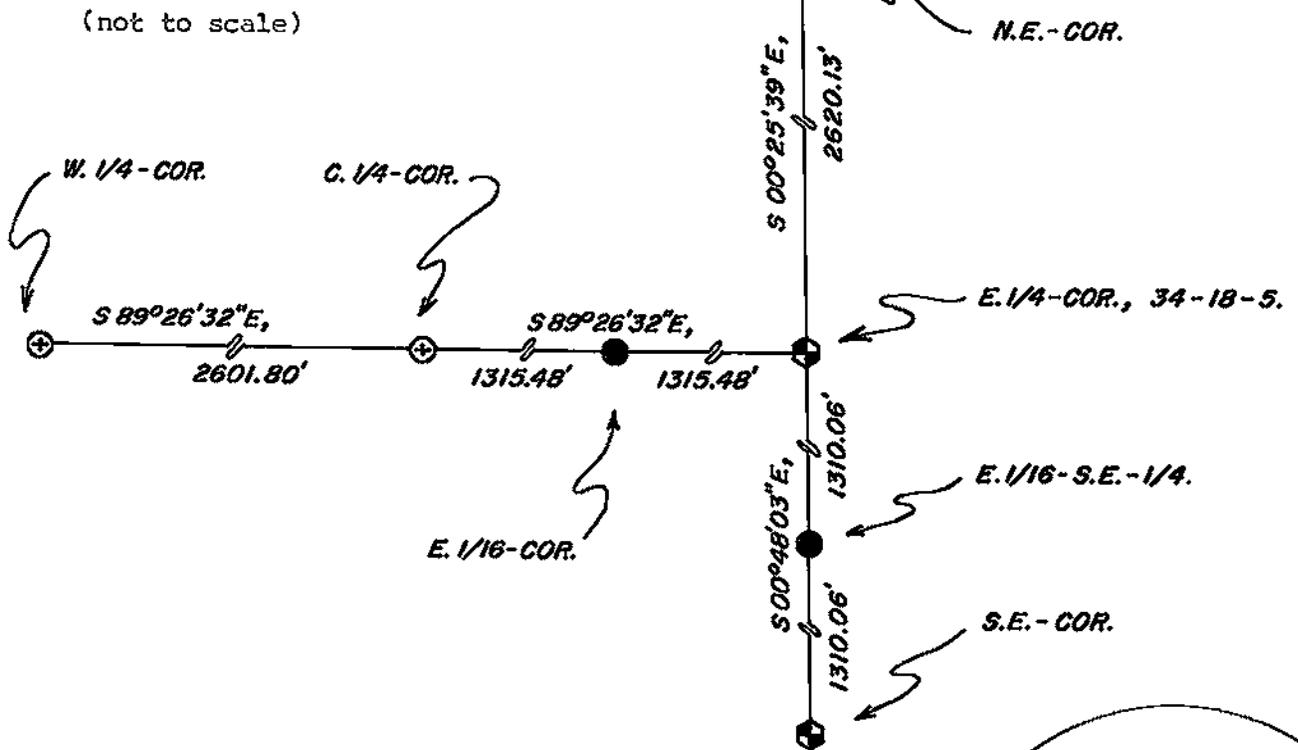

I, WILLIAM C. JUNG, COUNTY SURVEYOR  
HEREBY CERTIFY THAT THE CORNER LOCATION SHOWN ON THIS RECORD  
WAS DETERMINED BY ME OR UNDER MY DIRECTION AND CONTROL AND  
THAT THIS U. S. PUBLIC LAND SURVEY MONUMENT RECORD IS CORRECT  
AND COMPLETE TO THE BEST OF MY KNOWLEDGE AND BELIEF.

William C. Jung 11/24/99  
Signature Date



Seal