


21805352000

U. S. PUBLIC LAND SURVEY MONUMENT RECORD

SECTION 35 T 18 N, R 5 W, TOWN OF BURNS

LA CROSSE COUNTY

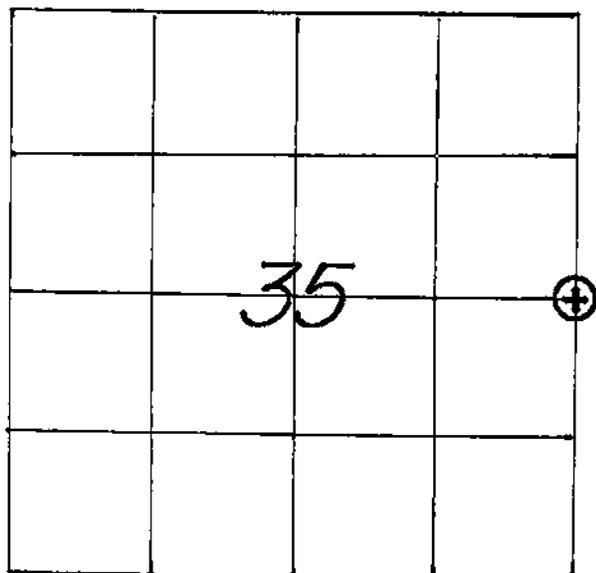

WISCONSIN COORDINATE SYSTEM

North 727,678.374

East 1,723,073.998

Theta Angle

Horiz. Order

Vert. Order

DATUM: 1983 ('91)

TYPE OF LANDMARK

3/4" x 30" IRON BAR WITH ALUMINUM CAP.

BEARINGS ARE REFERENCED TO

GRID NORTH AS PER SECTION DATA.

LOCATION OF LANDMARK

CREW: WILLIAM C. JUNG
 PETER F. FOLLANSBEE
 DATE: 1/15/2002

Describe any record evidence, monument evidence, testimonial evidence or any other material evidence you considered and whether the monument was found or restored through acceptance of an obliterated evidence location.

I set this corner by single proportionate measurement and monumented it with an iron bar and cap.

Describe or show any material discrepancy between the location of the restored corner and that of the corner previously restored or reestablished.

NONE KNOWN.


RECORD OF DURABLE WITNESS MONUMENTS

GROUND DIST.'s

NO	DESCRIPTION	BEARING	DISTANCE
1	SET REBAR AS A TRAVERSE POINT	S 60°12'05"W (GRID)	52.90 FT.
2	SET A NAIL IN S.W.-SIDE OF AN 11" HICKORY	N 60° W (MAG.)	27.21 FT.
3	SET A NAIL IN S.E.-SIDE OF AN 11" HICKORY	N 10° E (MAG.)	5.77 FT.
4	SET A NAIL IN S.W.-SIDE OF AN 11-1/2" CHERRY	S 65° E (MAG.)	10.62 FT.


(NOT TO SCALE)

(NOTE: THE THREE BEARING TREES ARE DOUBLE BLAZED.)

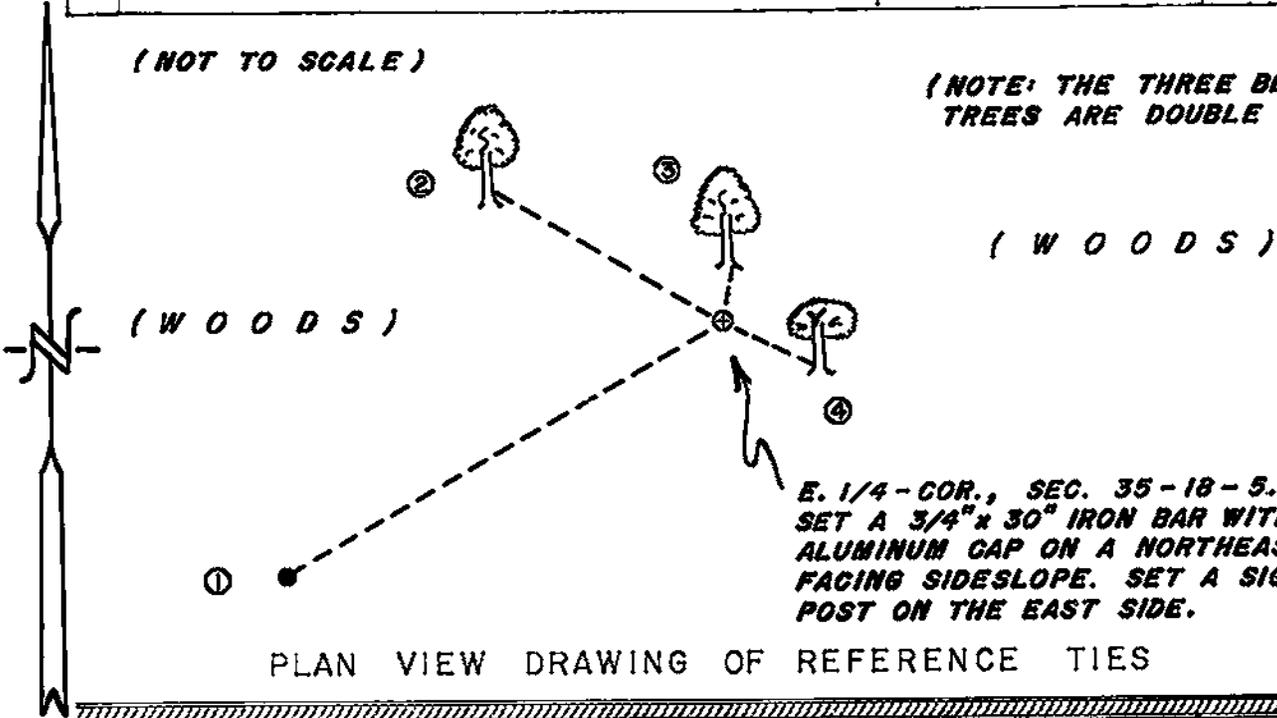


MAP SHOWING DISTANCE AND DIRECTION TO OTHER PUBLIC LAND SURVEY CORNERS USED FOR REESTABLISHING THE CORNER

(GRID BEARINGS & DISTANCES)
(GRID FACTOR: 0.999937783)
(NOT TO SCALE)

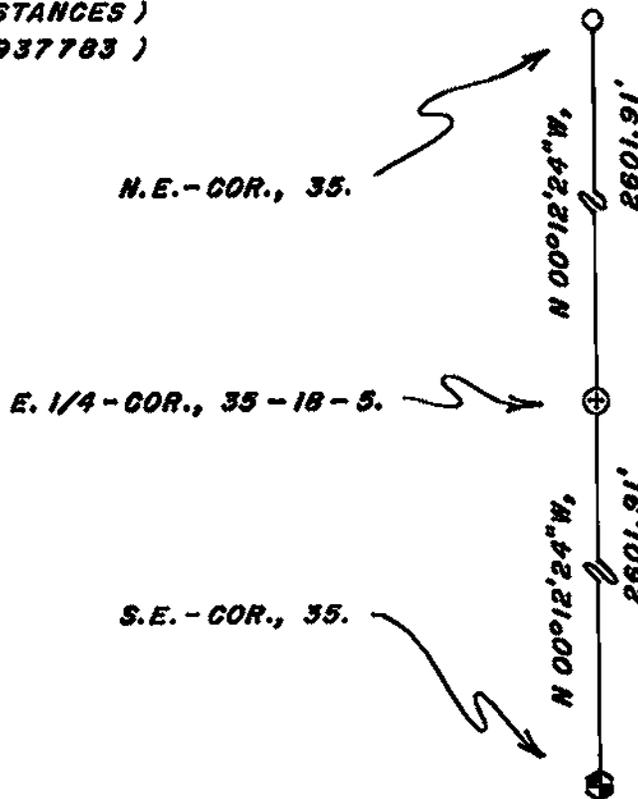

I, WILLIAM C. JUNG, COUNTY SURVEYOR
HEREBY CERTIFY THAT THE CORNER LOCATION SHOWN ON THIS RECORD WAS DETERMINED BY ME OR UNDER MY DIRECTION AND CONTROL AND THAT THIS U. S. PUBLIC LAND SURVEY MONUMENT RECORD IS CORRECT AND COMPLETE TO THE BEST OF MY KNOWLEDGE AND BELIEF.

William C. Jung 4/18/02
Signature Date

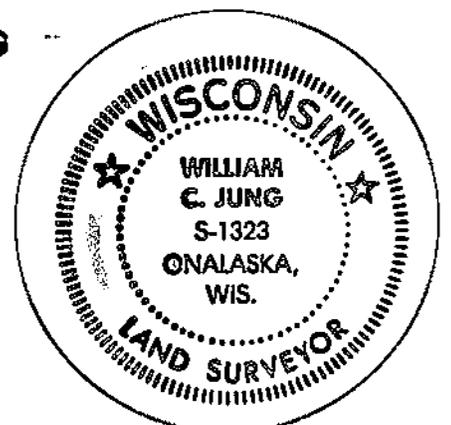

Seal