

CERTIFICATE

CERTIFIED LAND CORNER

No. 114

I, William C. Jung, do hereby certify that on the 14th day of January, 1975, I found (evidence) (see evidence) of the N 1/4 corner of Section 31, T. 18 N., R. 4 W., Fourth Principal Meridian, and I re-established said corner according to the Wisconsin Statutes as shown and described hereon.

Dated this 6th day of Dec., 1977.

William C. Jung, R.L.S. 13223

Crew Chief, County Surveyor's Office

History of original corner establishment:

No known history recorded since the original government survey.

Description of corner evidence found:

Accepted fence corner as best available evidence. Local land owner, Pat Haas, said this was the corner accepted by three land owners. Fits corner 1/2 mile South for distance and bearing. Set Harrison by old fence post at three way fence.



Description of corner and witness monuments, references and accessories used to perpetuate the original or re-established location of this corner:

Set Harrison, up 2", in Garbage pile.  
All trees blazed with N&C's set.

Witnesses to corner location:

W. Jung

G. Pietsz

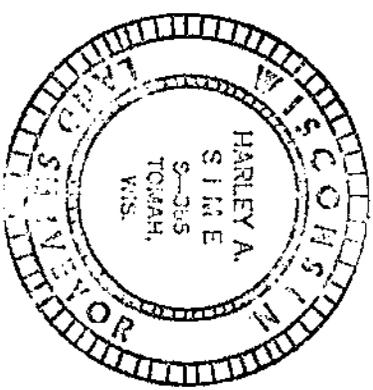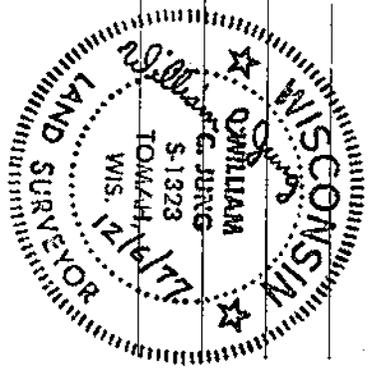

Approved: Harley Sime  
County Surveyor

SURVEY CONTROL ORDER

Horizontal \_\_\_\_\_

Vertical \_\_\_\_\_

Corner \_\_\_\_\_

Control Sta. Name \_\_\_\_\_

East (X) \_\_\_\_\_ North (Y) \_\_\_\_\_

WISCONSIN COORDINATE SYSTEM

Elevation (Z) \_\_\_\_\_ Zone \_\_\_\_\_

City, Village or Town Sparta

County of Monroe

