


21806130000

## U. S. PUBLIC LAND SURVEY MONUMENT RECORD

SECTION 18 T 18 N, R 5 W, TOWN OF FARMINGTON

LA CROSSE COUNTY

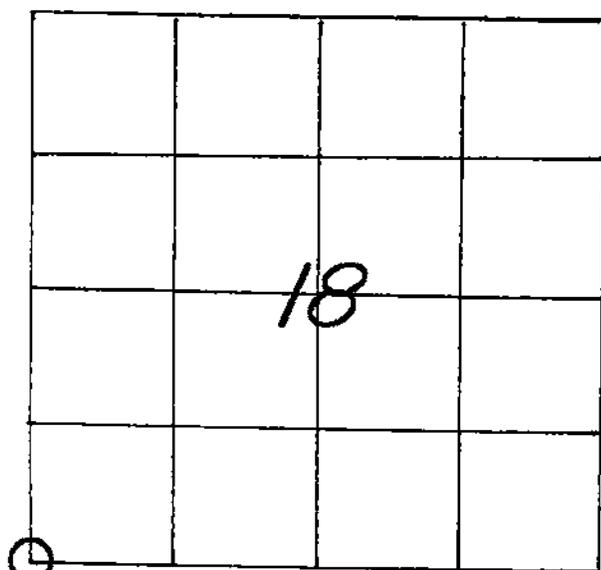

LOCATION OF LANDMARK

CREW: **WILLIAM C. JUNG**  
**PETER F. FOLLANSBEE**  
 DATE: **8/05/2004**

## WISCONSIN COORDINATE SYSTEM

North **740,978.685**East **1,696,979.543**

Theta Angle

Horiz. Order

Vert. Order

DATUM: **1983('91)**

TYPE OF LANDMARK

**2" x 30" IRON PIPE.**

BEARINGS ARE REFERENCED TO  
**GRID NORTH AS PER SECTION DATA.**

Describe any record evidence, monument evidence, testimonial evidence or any other material evidence you considered and whether the monument was found or restored through acceptance of an obliterated evidence location.

According to the original government survey notes there were five bearing trees of record. I found what I believe are the remnants of the Southeast bearing tree. The bearing tree was long dead, very rotted, on the ground, and probably dead and "petrified" before falling. The tree was 20 inches or so in diameter before dying.

Old Mr. Schliefer said that Civilian Conservation Corps surveyors found a tree near this corner when they were working in the area. What he described had to be a \*\*\*\*\* Describe or show any material discrepancy between the location of the restored corner and that of the corner previously restored or reestablished.

**NONE KNOWN.**

\*\*\*\*\* bearing tree. Using the original notes, I set the corner off of this bearing tree by measuring from the stump hole. We set a 2"x30" iron pipe at the corner with a sign and post also set to the East.


(over)

RECORD OF DURABLE WITNESS MONUMENTS

NO	DESCRIPTION	MAGNETIC	
		BEARING	DISTANCE
1	SET A NAIL IN W.-SIDE OF A 22" WHITE OAK	N 19° E	51.00 FT.
2	SET A NAIL IN S.E.-SIDE OF AN 18" WHITE OAK	N 65° E	82.05 FT.
3	SET A NAIL IN N.W.-SIDE OF A 12" WHITE OAK	EAST ±	69.21 FT.
4	SET A NAIL IN N.W.-SIDE OF A 14 1/2" HICKORY	S 61° E	11.65 FT.


(NOT TO SCALE)

(NOTE: THE FOUR BEARING TREES ARE DOUBLE BLAZED.)

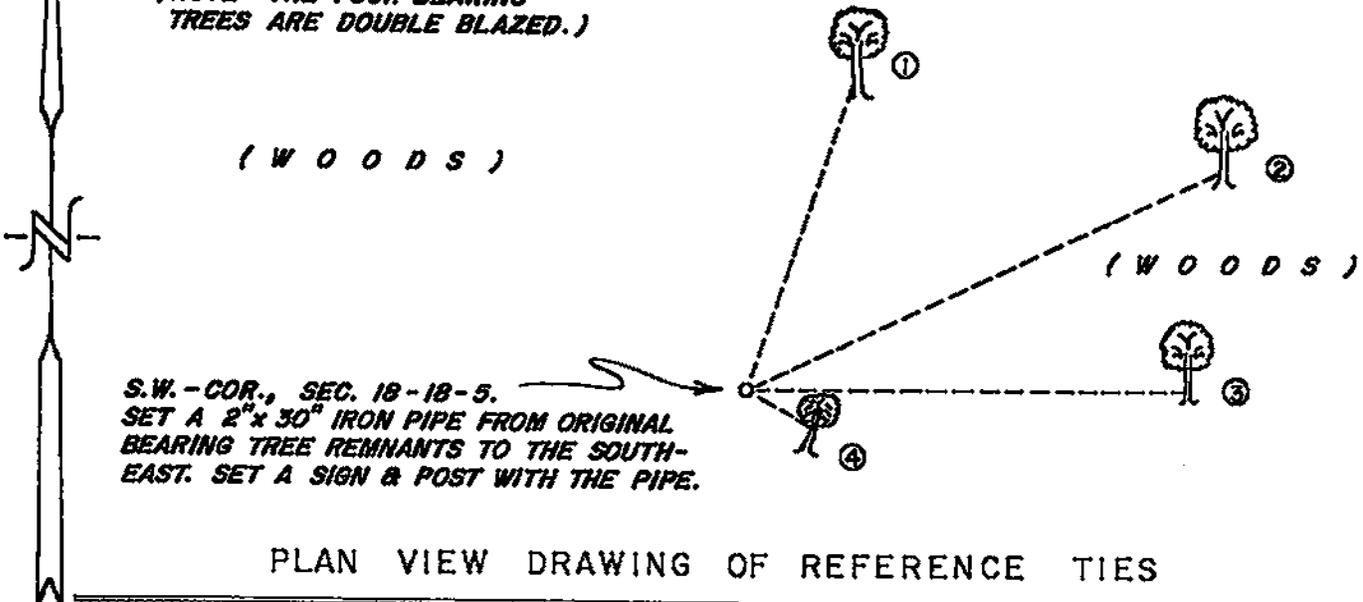

PLAN VIEW DRAWING OF REFERENCE TIES


MAP SHOWING DISTANCE AND DIRECTION TO OTHER PUBLIC LAND SURVEY CORNERS USED FOR REESTABLISHING THE CORNER

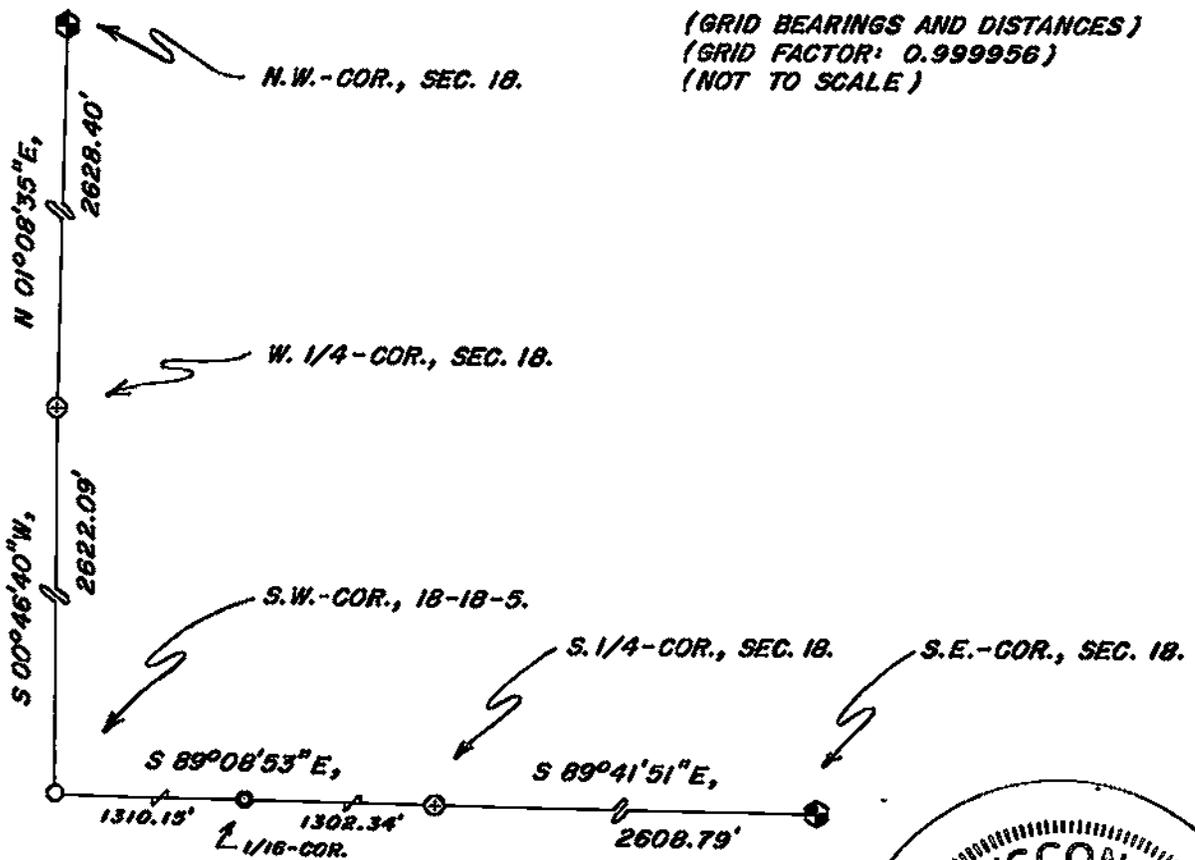

I, WILLIAM C. JUNG, COUNTY SURVEYOR  
 HEREBY CERTIFY THAT THE CORNER LOCATION SHOWN ON THIS RECORD  
 WAS DETERMINED BY ME OR UNDER MY DIRECTION AND CONTROL AND  
 THAT THIS U. S. PUBLIC LAND SURVEY MONUMENT RECORD IS CORRECT  
 AND COMPLETE TO THE BEST OF MY KNOWLEDGE AND BELIEF.

*William C. Jung*  
 Signature

12/31/04  
 Date

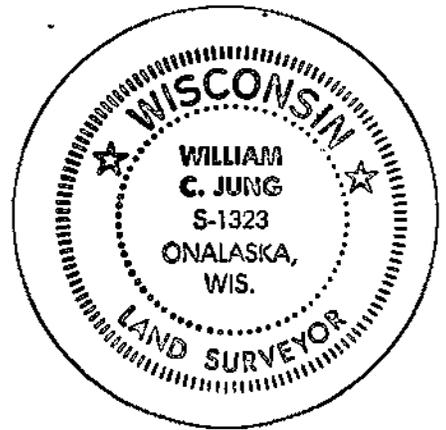

Seal