


U. S. PUBLIC LAND SURVEY MONUMENT RECORD

SECTION 18 T 18 N, R 5 W, TOWN OF FARMINGTON
LA CROSSE COUNTY

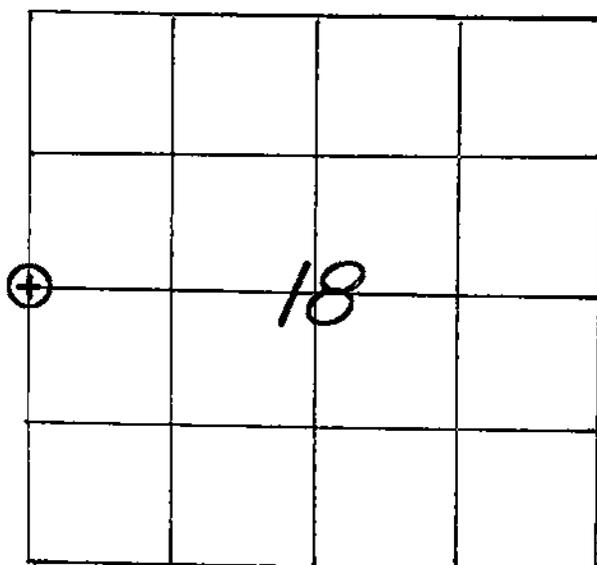

LOCATION OF LANDMARK

CREW: WILLIAM G. JUNG
PETER F. FOLLANSBEE
DATE: 8/04/2004

WISCONSIN COORDINATE SYSTEM	
North	743,600.535
East	1,697,015.134
Theta Angle	
Horiz. Order	
Vert. Order	
DATUM:	1983('91)
TYPE OF LANDMARK	
3/4" x 30" IRON BAR WITH AN ALUMINUM CAP.	
BEARINGS ARE REFERENCED TO	
GRID NORTH AS PER SECTION DATA.	

Describe any record evidence, monument evidence, testimonial evidence or any other material evidence you considered and whether the monument was found or restored through acceptance of an obliterated evidence location.


We found very old downed corner posts with tie wire at the occupied corner. The corner could be described as "ancient". I accepted this old occupied corner as the best available evidence of the original government corner position and monumented it with an iron bar and cap. A sign and post were set nearby.

Describe or show any material discrepancy between the location of the restored corner and that of the corner previously restored or reestablished.


NONE KNOWN.

RECORD OF DURABLE WITNESS MONUMENTS

NO	DESCRIPTION	MAGNETIC	
		BEARING	DISTANCE
1	SET A NAIL IN S.E.-SIDE OF A 16" ELM	S 79° W	11.22 FT.
2	SET A NAIL IN W.-SIDE OF A 16" HICKORY	SOUTH ±	11.83 FT.
3	SET A NAIL IN N.E.-SIDE OF A 14-1/2" HICKORY	S 48° E	9.44 FT.
4	SET A NAIL IN N.E.-SIDE OF A 12-1/2" HICKORY	S 66° E	10.65 FT.

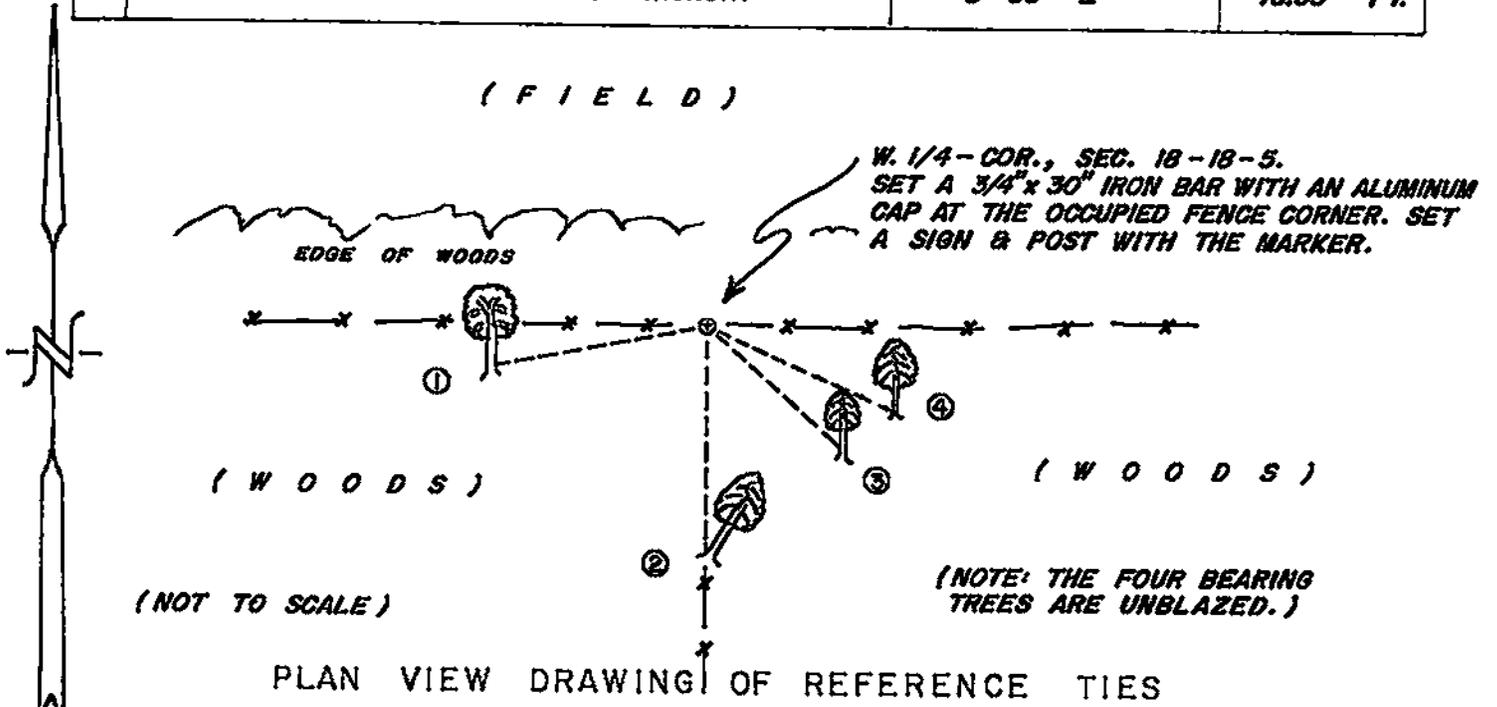

MAP SHOWING DISTANCE AND DIRECTION TO OTHER PUBLIC LAND SURVEY CORNERS USED FOR REESTABLISHING THE CORNER

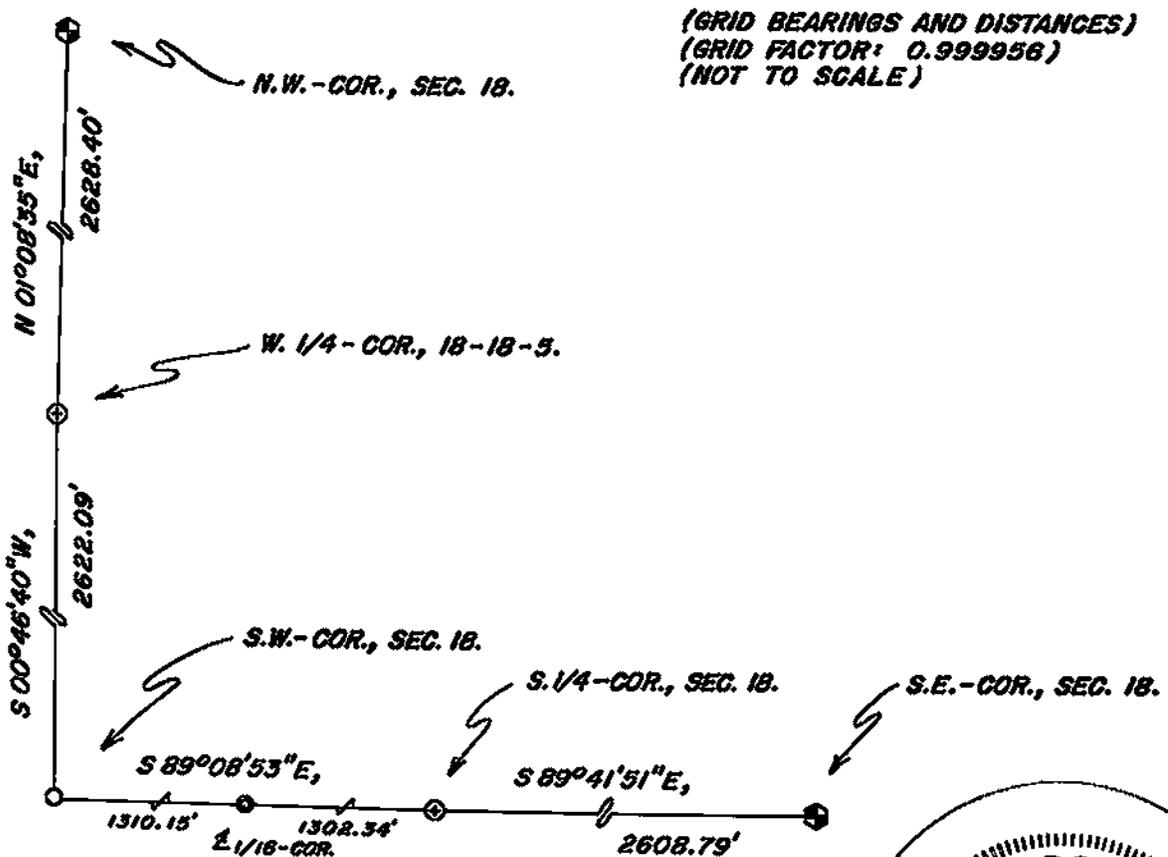

I, WILLIAM C. JUNG, COUNTY SURVEYOR
HEREBY CERTIFY THAT THE CORNER LOCATION SHOWN ON THIS RECORD WAS DETERMINED BY ME OR UNDER MY DIRECTION AND CONTROL AND THAT THIS U. S. PUBLIC LAND SURVEY MONUMENT RECORD IS CORRECT AND COMPLETE TO THE BEST OF MY KNOWLEDGE AND BELIEF.

William C. Jung
Signature

12/31/04
Date



Seal