


## U. S. PUBLIC LAND SURVEY MONUMENT RECORD

SECTION 30 T 18 N, R 5 W, TOWN OF FARMINGTON

LA CROSSE COUNTY

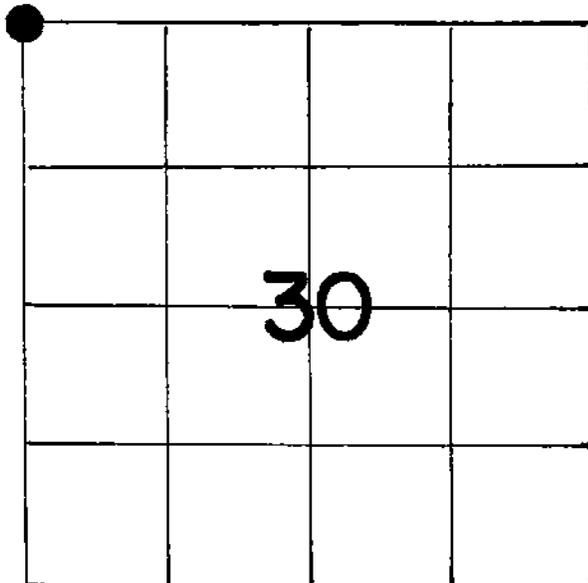

WISCONSIN COORDINATE SYSTEM

North

East

Theta Angle

Horiz. Order

Vert. Order

TYPE OF LANDMARK  
1½" IRON PIPE

BEARINGS ARE REFERENCED TO

True

## LOCATION OF LANDMARK

Crew: William Jung  
Perry Dahl

5/29/85

Describe any record evidence, monument evidence, testimonial evidence or any other material evidence you considered and whether the monument was found or restored through acceptance of an obliterated evidence location.


I found an iron pipe at the corner. Hurlburt used this corner in May of 1985. I do not know who set the pipe. It may have been Murphy or Hofmeister. I accepted it as the best available evidence of the original government corner position.

Describe or show any material discrepancy between the location of the restored corner and that of the corner previously restored or reestablished.

None known.

RECORD OF DURABLE WITNESS MONUMENTS


NO	DESCRIPTION	BEARING	DISTANCE
1	CENTER OF STREET SIGN POST	N25°W =Mag.	22.89'
2	SET 1½" IRON PIPE (on S. sh. of rd.)	-----	42.27'
3	SET 1½" IRON PIPE " "	-----	42.88'
4	CENTER OF TELEPHONE BOX	N5°E =Mag.	34.85'

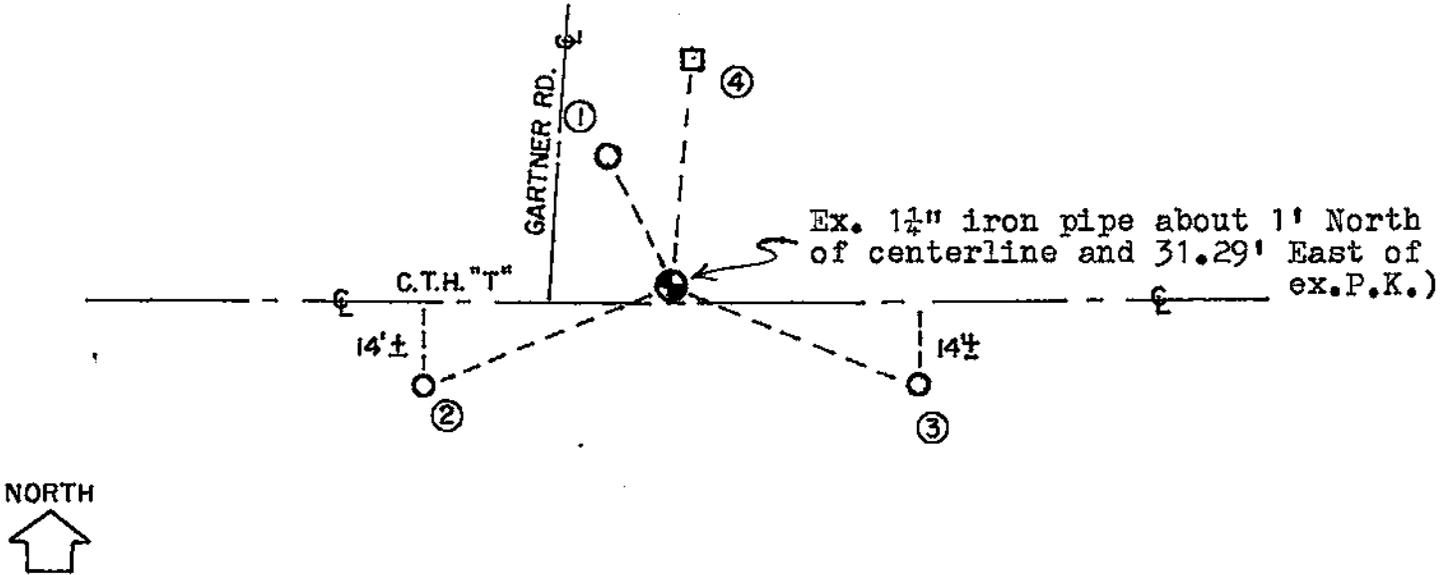

PLAN VIEW DRAWING OF REFERENCE TIES

MAP SHOWING DISTANCE AND DIRECTION TO OTHER PUBLIC LAND SURVEY CORNERS USED FOR REESTABLISHING THE CORNER


(not to scale)

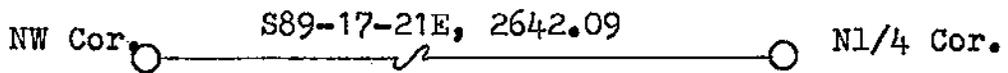

I, William C. Jung, Deputy County Surveyor,  
 HEREBY CERTIFY THAT THE CORNER LOCATION SHOWN ON THIS RECORD  
 WAS DETERMINED BY ME OR UNDER MY DIRECTION AND CONTROL AND  
 THAT THIS U. S. PUBLIC LAND SURVEY MONUMENT RECORD IS CORRECT  
 AND COMPLETE TO THE BEST OF MY KNOWLEDGE AND BELIEF.

*William C. Jung*  
 Signature

2/28/86  
 Date

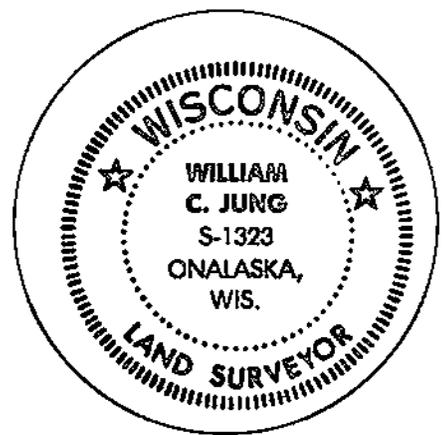

Seal