


21806250000

U. S. PUBLIC LAND SURVEY MONUMENT RECORD

SECTION 31 T 18 N, R 5 W, TOWN OF FARMINGTON

LA CROSSE COUNTY

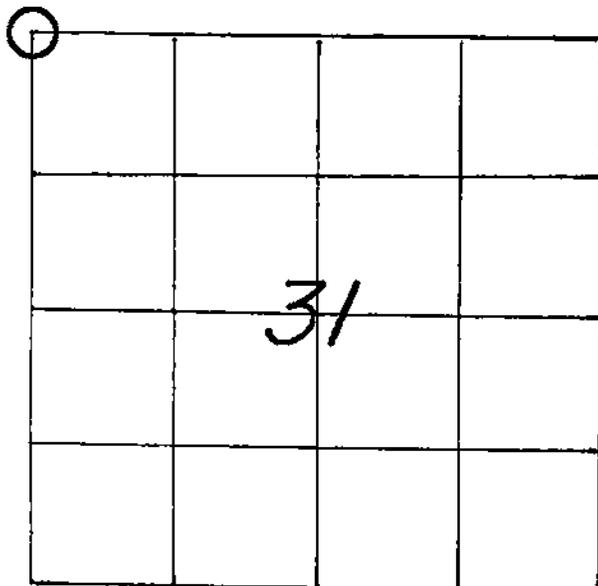

LOCATION OF LANDMARK

CREW: WILLIAM C. JUNG
 PETER F. FOLLANSBEE
 DATE: 10/21/2004

WISCONSIN COORDINATE SYSTEM
North
East
Theta Angle
Horiz. Order
Vert. Order
TYPE OF LANDMARK
1-3/4" x 7/8" I. PIPE SET AS A WITNESS CORNER.
BEARINGS ARE REFERENCED TO
LACROSSE COUNTY COORDINATE SYSTEM NORTH AS PER THE SECTION DATA.

Describe any record evidence, monument evidence, testimonial evidence or any other material evidence you considered and whether the monument was found or restored through acceptance of an obliterated evidence location.

Greg Hofmeister computed out a location for this corner in 1979 but never set a monument at the final location. The corner falls in a swampy wetland. Paul Fairchild and Norm Hurlburt later did surveys based on Hofmeister's location. I set the corner based on Hurlburt's traverse data. The pipe set is a witness corner and falls 0.18 ft. East of the computed section corner location. The pipe is set in swampy muck and is over 6 feet long. I did not go back to adjust it. I would suggest that unless it's winter, describe or show any material discrepancy between the location of the restored corner and that of the corner previously restored or reestablished.

that future surveyors use our ties and not go out to this location.

NONE KNOWN.

