


21905310000

## U. S. PUBLIC LAND SURVEY MONUMENT RECORD

SECTION 5 T 18 N, R 5 W, TOWN OF FARMINGTON

LA CROSSE COUNTY

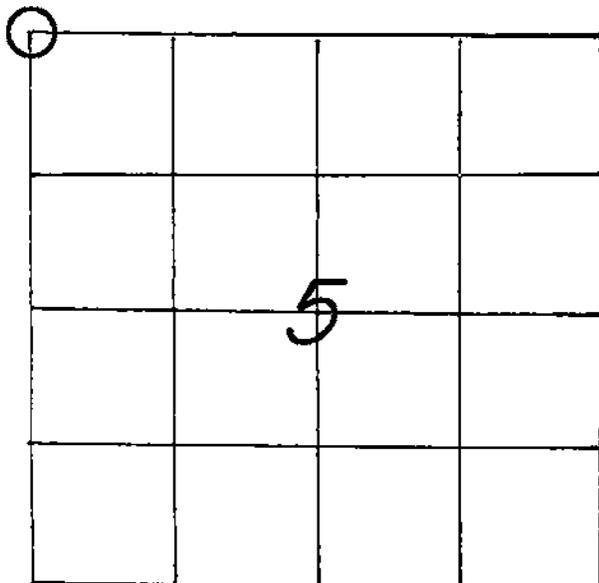

LOCATION OF LANDMARK

CREW: WILLIAM C. JUNG  
 PETER F. FOLLANSBEE  
 DATE: 4/22/2005

## WISCONSIN COORDINATE SYSTEM

North

East

Theta Angle

Horiz. Order

Vert. Order

## TYPE OF LANDMARK

**BRASS CAPPED IRON PIPE.**

BEARINGS ARE REFERENCED TO

**ASSUMED NORTH AS PER SECTION DATA.**

Describe any record evidence, monument evidence, testimonial evidence or any other material evidence you considered and whether the monument was found or restored through acceptance of an obliterated evidence location.

I found a brass capped pipe at the corner and took new ties.

Describe or show any material discrepancy between the location of the restored corner and that of the corner previously restored or reestablished.

**NONE KNOWN.**



# Government Land Corner Certificate

## Jackson County

CORNER VOL. \_\_\_\_\_ PAGE NO. 11

CORNER # \_\_\_\_\_

TYPE OF MONUMENT: 2" x 60" Brass Capped Pipe

SECTION 32, T 19, N, R. 5W

STATE PLANE COORDINATES: N \_\_\_\_\_

E \_\_\_\_\_


ELEVATION — M.S.L. DATUM: \_\_\_\_\_

THETA ANGLE: \_\_\_\_\_

FIELD BOOK: HSE File B2N-004

DRAWN BY: N.R. Hurlburt page \_\_\_\_\_

REFERENCED FOR SURVEY RECORDED IN: \_\_\_\_\_

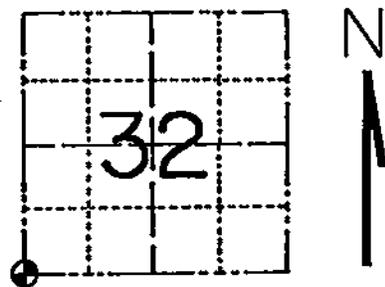

LOCATION  
(Shown by monument symbol)

### BASIS FOR MONUMENT LOCATION

Show info such as: History of corner, with reference to Vol. and pg., dates, surveyor; exact description of monument replaced; if location computed, by taped or EDM traverse; landowner remarks, etc. (Use reverse side if necessary)

Ray W. Hurlburt, in County Survey Record No. 2139, Vol. 6, P. 187, dated 1965, records an extensive investigation into the location of this corner and those west of it. He concluded that the best location was on the line of the fence south and 1½ rods North of the old south road fence. He set a brass capped pipe at this point. I found his pipe up 14" at a new fence corner. The corner fence post, a RR tie, is set in concrete which also surrounds the pipe. I nailed a witness sign on the post which is about 0.3 foot East of the pipe.

SEAL:



DATA SHOWN HERE ON CERTIFIED CORRECT:

*Norman R. Hurlburt*

Registered Land Surveyor

DATE: Dec. 29, 1982

### TIE SKETCH

Show at least four ties, also fence lines, roads, topo, size and type of witness trees' and if off road - best way to arrive at corner.

