

Government Land Corner Certificate
Jackson County

LA X
 County

CORNER VOL. _____ PAGE NO. 12

CORNER # **21905310020**

SECTION 31, T. 19, N. R. 5W

TYPE OF MONUMENT: 2" x 60" Brass Capped Pipe

STATE PLANE COORDINATES: N. _____

E. _____


ELEVATION - M.S.L. DATUM: _____

THETA ANGLE: _____

FIELD BOOK: HSE File B2N-004

DRAWN BY: N.R. Hurlburt page _____

REFERENCED FOR SURVEY RECORDED IN: _____

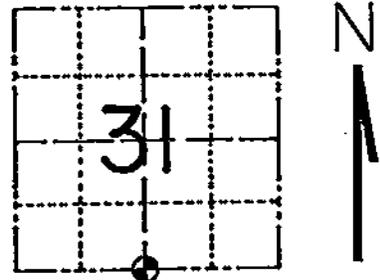

LOCATION
 (Shown by monument symbol)

BASIS FOR MONUMENT LOCATION

Show info such as: History of corner, with reference to Vol. and pg., dates, surveyor; exact description of monument replaced; if location computed, by taped or EDM traverse; landowner remarks, etc. (Use reverse side if necessary)

Ray W. Hurlburt, in County Survey Record No. 2139, Vol. 6, P. 187, dated 1965, records an extensive investigation into the location of this corner and those immediately east and west from it. He concluded that this corner should be at proportionate distance between section corners and 1½ rods North of the old south road fence. He set a brass capped pipe at the corner and drove the grader blade which I used for a reference. I drove his pipe down flush and drove a steel witness post with sign, 1.0 foot North.

SEAL:



DATA SHOWN HERE ON
 CERTIFIED CORRECT:


Norman R. Hurlburt

Registered Land Surveyor

DATE: DEC. 29, 1982

TIE SKETCH

Show at least four ties, also fence lines, roads, topo, size and type of witness trees and if off road - best way to arrive at corner.

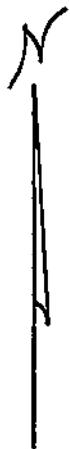

SCALE
 1" = 40'

EXISTING GRADER BLADE,
 UP 2' AT FENCE CORNER.

