


U. S. PUBLIC LAND SURVEY MONUMENT RECORD

SECTION 5 T 18 N, R 5 W, TOWN OF FARMINGTON

LA CROSSE COUNTY

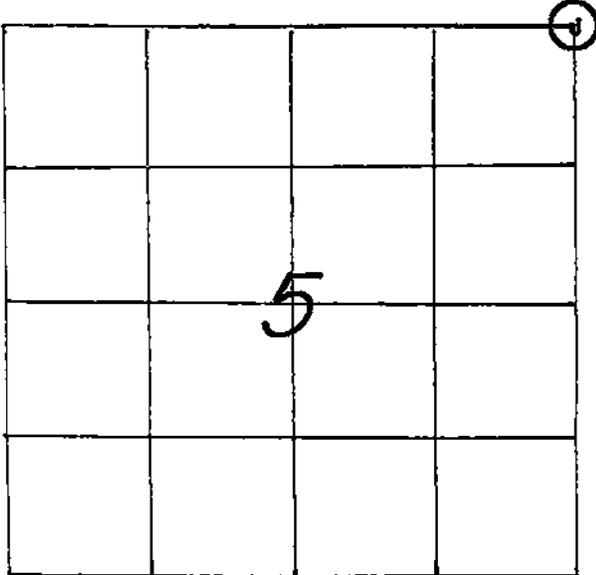

LOCATION OF LANDMARK

CREW: WILLIAM C. JUNG
 PETER F. FOLLANSBEE
 DATE: 3/15/2008

WISCONSIN COORDINATE SYSTEM

North

East

Theta Angle

Horiz. Order

Vert. Order

TYPE OF LANDMARK

3/4" BRASS CAP JACKSON COUNTY MARKER.

BEARINGS ARE REFERENCED TO

ASSUMED NORTH AS PER SECTION DATA.

Describe any record evidence, monument evidence, testimonial evidence or any other material evidence you considered and whether the monument was found or restored through acceptance of an obliterated evidence location.


I found a Jackson County marker at the corner and took new ties.

Describe or show any material discrepancy between the location of the restored corner and that of the corner previously restored or reestablished.

NONE KNOWN.


RECORD OF DURABLE WITNESS MONUMENTS

NO	DESCRIPTION	MAGNETIC	
		BEARING	DISTANCE
1	SET A NAIL IN S.-SIDE OF A 9" OAK	N 79° W	22.94 FT.
2	SET A NAIL IN N.-SIDE OF A 10" OAK	S 82° E	20.04 FT.
3	SET A NAIL IN S.W.-SIDE OF A 10" JACK PINE	S 39° E	51.66 FT.
4	SET A NAIL IN S.E.-SIDE OF AN 8-1/2" JACK PINE	S 41° W	26.02 FT.

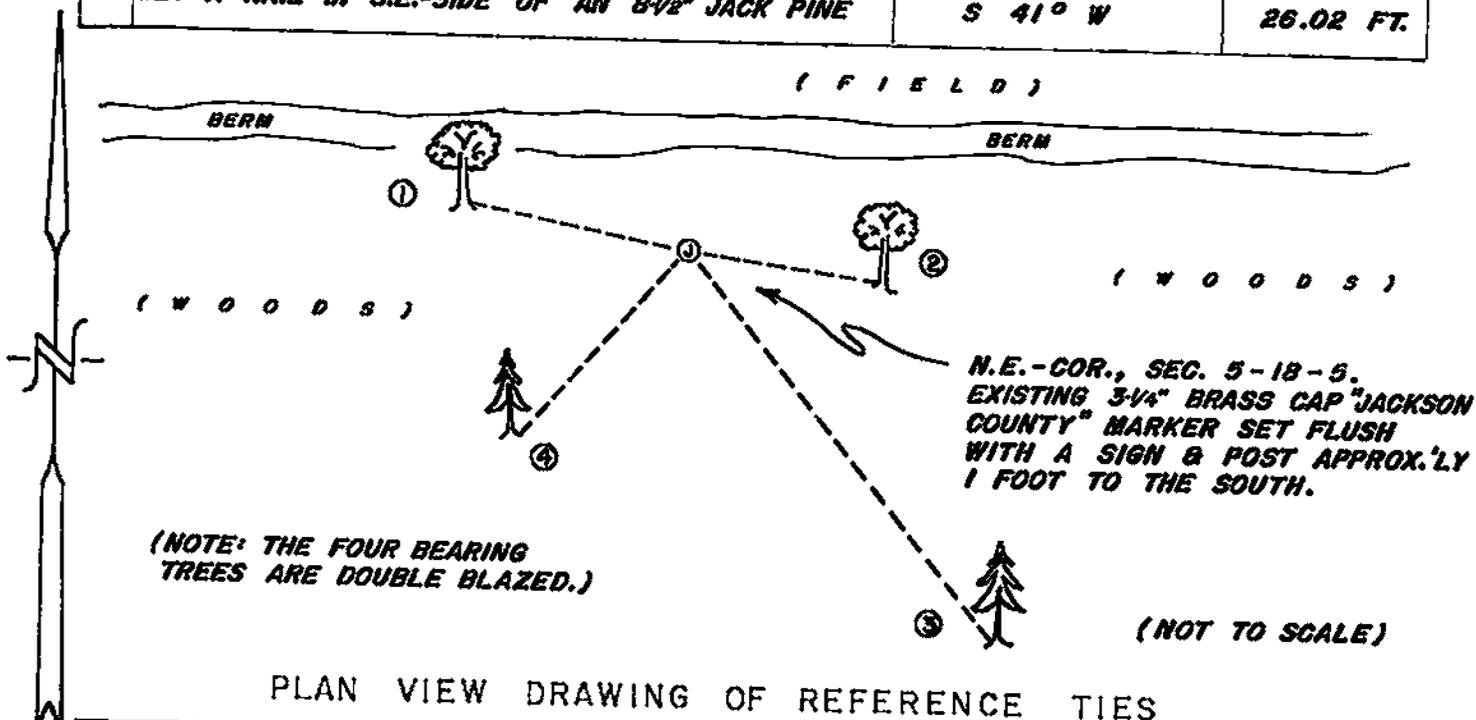


MAP SHOWING DISTANCE AND DIRECTION TO OTHER PUBLIC LAND SURVEY CORNERS USED FOR REESTABLISHING THE CORNER

(N.R. HURLBURT MEASUREMENTS)
(ASSUMED BEARINGS)
(NOT TO SCALE)

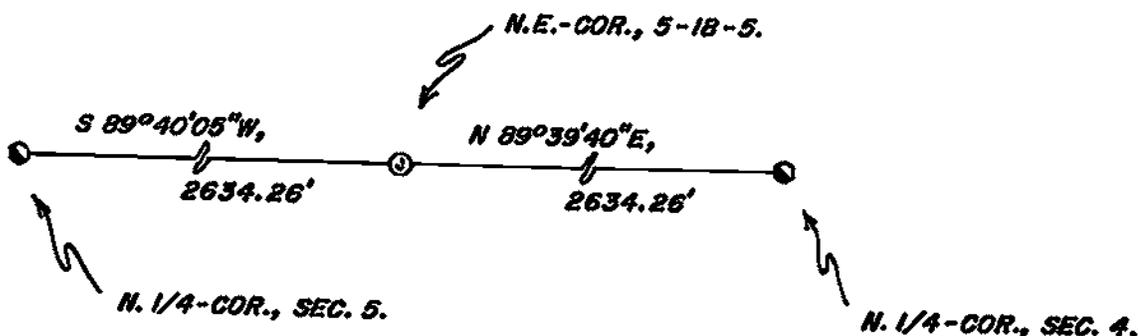

I, WILLIAM C. JUNG, COUNTY SURVEYOR
HEREBY CERTIFY THAT THE CORNER LOCATION SHOWN ON THIS RECORD WAS DETERMINED BY ME OR UNDER MY DIRECTION AND CONTROL AND THAT THIS U. S. PUBLIC LAND SURVEY MONUMENT RECORD IS CORRECT AND COMPLETE TO THE BEST OF MY KNOWLEDGE AND BELIEF.

William C. Jung 3/14/06
Signature Date

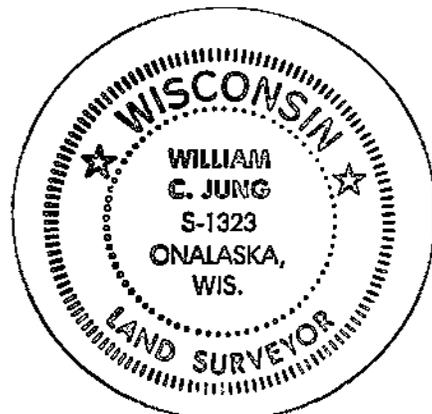


Seal

Government Land Corner Certificate

Jackson County

CORNER VOL. _____ PAGE NO. 9
 CORNER # _____
 SECTION 32 T. 19 N. R. 5W

TYPE OF MONUMENT: 30" Berntsen Cast Aluminum
 STATE PLANE COORDINATES: N _____
 E _____
 ELEVATION — M.S.L. DATUM: _____
 THETA ANGLE: _____
 FIELD BOOK: HSE File 82N-018
 DRAWN BY: N.R. Hurlburt page _____
 REFERENCED FOR SURVEY RECORDED IN: _____

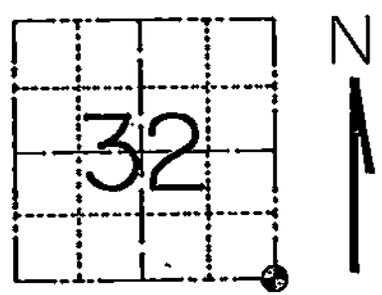

BASIS FOR MONUMENT LOCATION

Show info such as: History of corner, with reference to Vol. and pg., dates, surveyor; exact description of monument replaced; if location computed, by taped or EDM traverse; landowner remarks, etc. (Use reverse side if necessary)

In Jackson County Survey Record No. 1748, Vol. 5, P. 226, done about 1945, David A. Blencoe searched for this corner without finding anything. He comments that proper re-establishment of the quarter corner north of here "would involve anyway 3 and maybe 6 miles of line to be run and measured." Apparently he found, as I did, that corner evidence on the township line was very scarce. After verifying the location of the SE corner of Section 33 (see that corner certificate), I re-established this corner midway between there and the SW of 32, and on a straight line corrected for curvature. The distance between these corners is very good, 5.7 feet short per half mile. The distance to the corner 1 mile north is about 35 feet long. The distance 1 mile south is about 85 ft. short. This indicates maybe the corner should move north, but what meager occupation evidence there is east of here indicates the line should go farther south. The shortage to the south could be largely explained by the original surveyors' failure to chain accurately over a rather high, steep hill. The excess to the north is large, but overall, I feel the proportioned position is as good as any. (continued on reverse side)

LOCATION
(Shown by monument symbol)



SEAL:

DATA SHOWN HERE ON CERTIFIED CORRECT:
Norman R. Hurlburt
 Registered Land Surveyor
 DATE: Dec. 30, 1982

TIE SKETCH

Show at least four ties, also fence lines, roads, topo, size and type of witness trees' and if off road - best way to arrive at corner.

FIELD

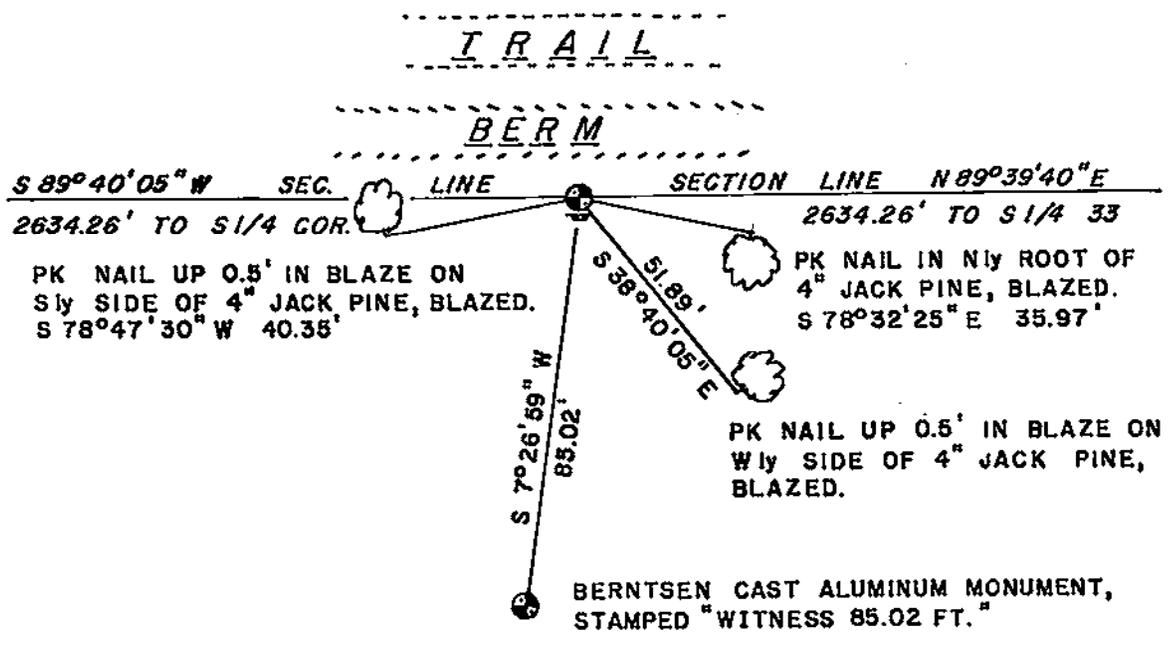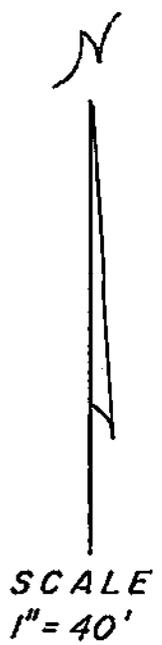

I monumented the proportioned corner with a Berntsen and drove a steel witness post with sign 1.0 foot South. The Berntsen witness monument shown on the sketch was set as the corner by the La Crosse County Surveyor a few years ago, but, to my knowledge, has not been used for any surveys. I have worked closely with him on this project and we have agreed on the new location for this corner.