


U. S. PUBLIC LAND SURVEY MONUMENT RECORD

SECTION 5 T 18 N, R 5 W, TOWN OF FARMINGTON

LA CROSSE COUNTY

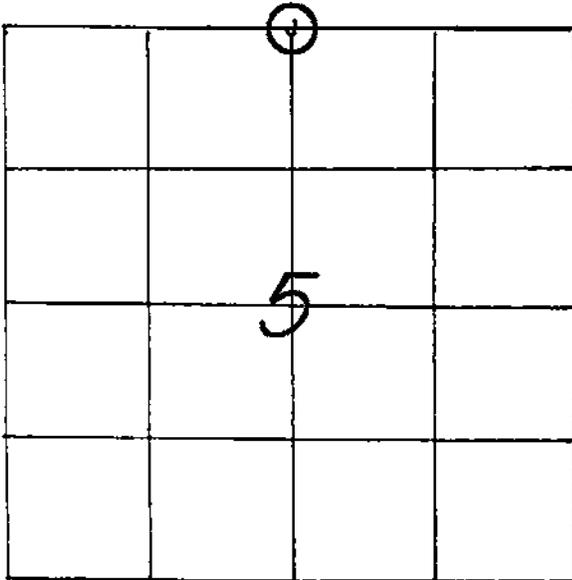

LOCATION OF LANDMARK

CREW: WILLIAM C. JUNG
 PETER F. FOLLANSBEE
 DATE: 3/14/2005

WISCONSIN COORDINATE SYSTEM

North

East

Theta Angle

Horiz. Order

Vert. Order

TYPE OF LANDMARK

3/4" BRASS CAP JACKSON COUNTY MARKER.

BEARINGS ARE REFERENCED TO

ASSUMED NORTH AS PER SECTION DATA.

Describe any record evidence, monument evidence, testimonial evidence or any other material evidence you considered and whether the monument was found or restored through acceptance of an obliterated evidence location.


I found a Jackson County monument and took new ties.

Describe or show any material discrepancy between the location of the restored corner and that of the corner previously restored or reestablished.

None known.


RECORD OF DURABLE WITNESS MONUMENTS

NO	DESCRIPTION	MAGNETIC	
		BEARING	DISTANCE
1	SET A NAIL IN S.W.-SIDE OF A 7" JACK PINE	N 16° W	57.74 FT.
2	SET A NAIL IN S.E.-SIDE OF A 12" OAK	N 46° E	37.45 FT.
3	SET A NAIL IN S.-SIDE OF A 6" JACK PINE	S 84° E	43.59 FT.
4	EXISTING BERNTSEN MARKER WITH A 4" TOP	S 07° W	42.71 FT.

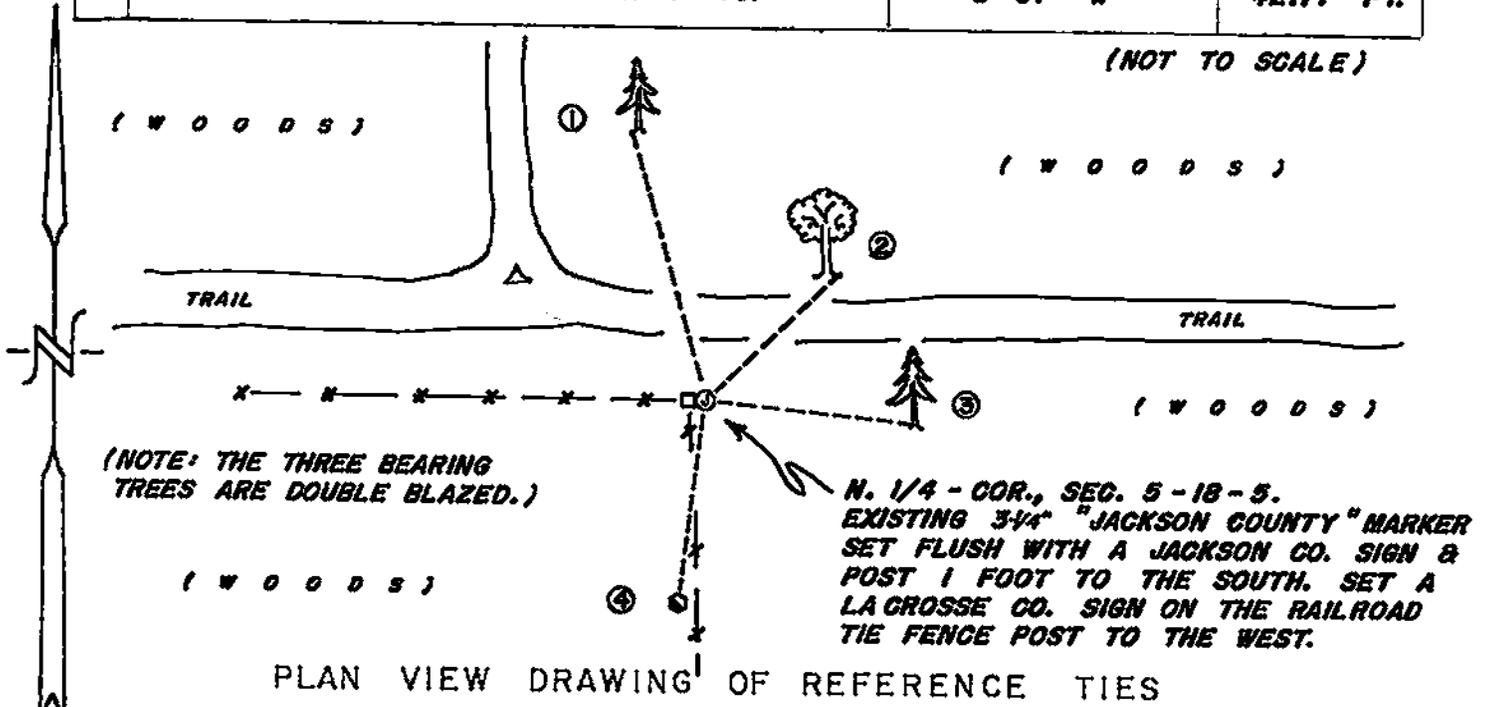

MAP SHOWING DISTANCE AND DIRECTION TO OTHER PUBLIC LAND SURVEY CORNERS USED FOR REESTABLISHING THE CORNER


(N.R. HURLBURT MEASUREMENTS)
 (ASSUMED BEARINGS)
 (NOT TO SCALE)

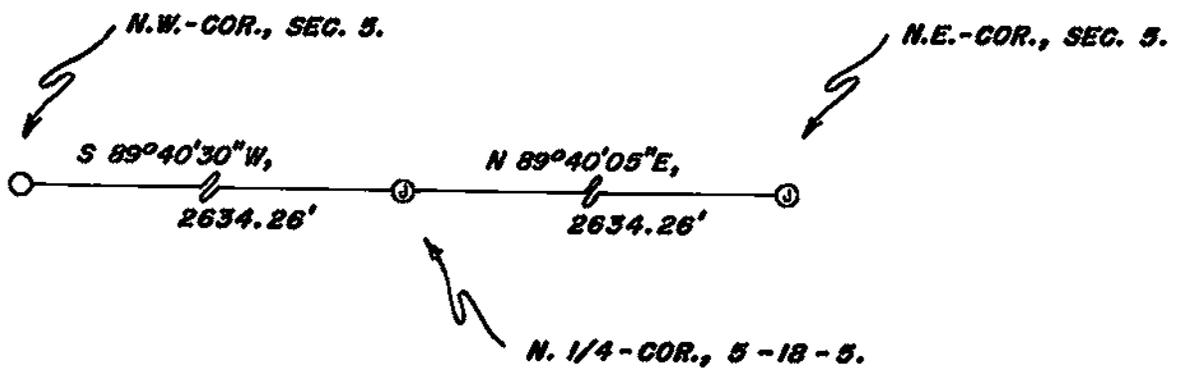

I, WILLIAM C. JUNG, COUNTY SURVEYOR
 HEREBY CERTIFY THAT THE CORNER LOCATION SHOWN ON THIS RECORD
 WAS DETERMINED BY ME OR UNDER MY DIRECTION AND CONTROL AND
 THAT THIS U. S. PUBLIC LAND SURVEY MONUMENT RECORD IS CORRECT
 AND COMPLETE TO THE BEST OF MY KNOWLEDGE AND BELIEF.

William C. Jung
 Signature

3/14/06
 Date

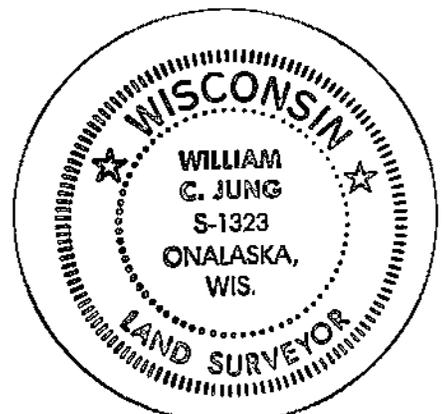

Seal

Government Land Corner Certificate
Jackson County

CORNER VOL. _____ PAGE NO. 10

CORNER# _____

SECTION 32, T. 19 N., R. 5W

TYPE OF MONUMENT: 30" Berntsen Cast Aluminum

STATE PLANE COORDINATES: N _____

E _____


ELEVATION — M.S.L. DATUM: _____

THETA ANGLE: _____

FIELD BOOK: HSE File 82N-004

DRAWN BY: N.R. Hurlburt page _____

REFERENCED FOR SURVEY RECORDED IN: _____

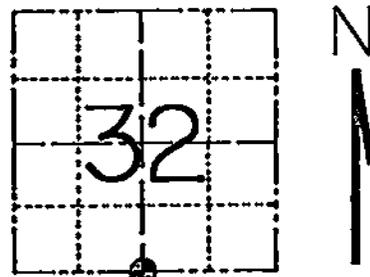

LOCATION
 (Shown by monument symbol)

BASIS FOR MONUMENT LOCATION

Show info such as: History of corner, with reference to Vol. and pg., dates, surveyor; exact description of monument replaced; if location computed, by taped or EDM traverse; landowner remarks, etc. (Use reverse side if necessary)

I have found no record of this corner being used or re-monumented since the original survey, except that, a few years ago, the La Crosse County Surveyor set the monument shown below as a witness. After extensive investigation, I verified the SE corner of Section 33, then re-established this corner at proportionate distance and on a straight line corrected for curvature, between there and the SW 32. (See corner certificates on SE 32 and SE 33.) This position falls about on the centerline of a trail which I assumed to be the remains of an old public road. That road, according to testimony given in Jackson County Survey Record No. 2139, Vol. 6, P. 189 dated 1965, was on the township line. The proportioned distance is only 5.7 feet per half mile short, which I feel is very good.

I worked in conjunction with the La Crosse County Surveyor on this re-establishment, and we agreed on the new corner position. We set a 30" Berntsen monument at the corner and drove a steel witness post with sign 1.0 foot South.

SEAL:



DATA SHOWN HERE ON CERTIFIED CORRECT:

Norman R. Hurlburt

Registered Land Surveyor

DATE: Dec. 29, 1982

TIE SKETCH

Show at least four ties, also fence lines, roads, topo, size and type of witness trees' and if off road - best way to arrive at corner.

