


U. S. PUBLIC LAND SURVEY MONUMENT RECORD

SECTION 3 T 18 N, R 5 W, TOWN OF FARMINGTON

LA CROSSE COUNTY

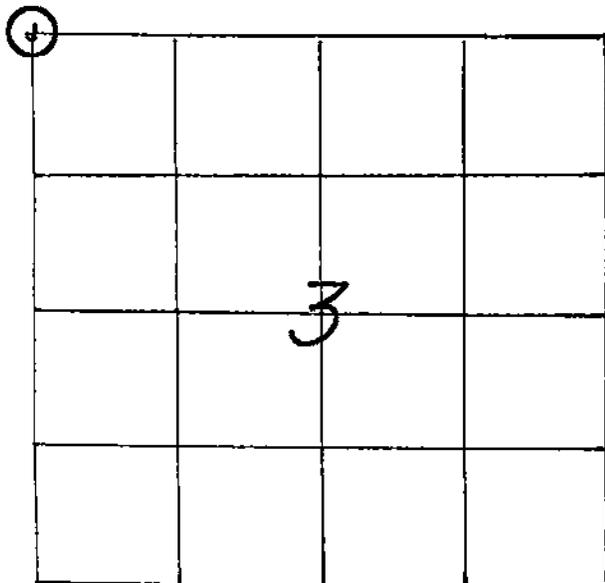

WISCONSIN COORDINATE SYSTEM
North
East
Theta Angle
Horiz. Order
Vert. Order

TYPE OF LANDMARK  
**3" ALUMINUM "JACKSON COUNTY" MARKER.**

BEARINGS ARE REFERENCED TO  
**ASSUMED NORTH AS PER SECTION DATA.**

LOCATION OF LANDMARK

CREW: **WILLIAM C. JUNG**  
**PETER F. FOLLANSBEE**  
 DATE: **3/28/2005**

Describe any record evidence, monument evidence, testimonial evidence or any other material evidence you considered and whether the monument was found or restored through acceptance of an obliterated evidence location.


I found a Jackson County monument and took new ties.

Describe or show any material discrepancy between the location of the restored corner and that of the corner previously restored or reestablished.

**NONE KNOWN.**


RECORD OF DURABLE WITNESS MONUMENTS

NO.	DESCRIPTION	MAGNETIC	
		BEARING	DISTANCE
1	SET A NAIL IN S.-SIDE OF A 6" NORWAY	N 84° W	30.00 FT.
2	SET A NAIL IN S.W.-SIDE OF A 7" NORWAY	N 24° W	69.24 FT.
3	SET A NAIL IN S.E.-SIDE OF A 5" OAK	N 40° E	50.17 FT.
4	SET A NAIL IN N.-SIDE OF A 6" CHERRY	S 87° E	28.82 FT.

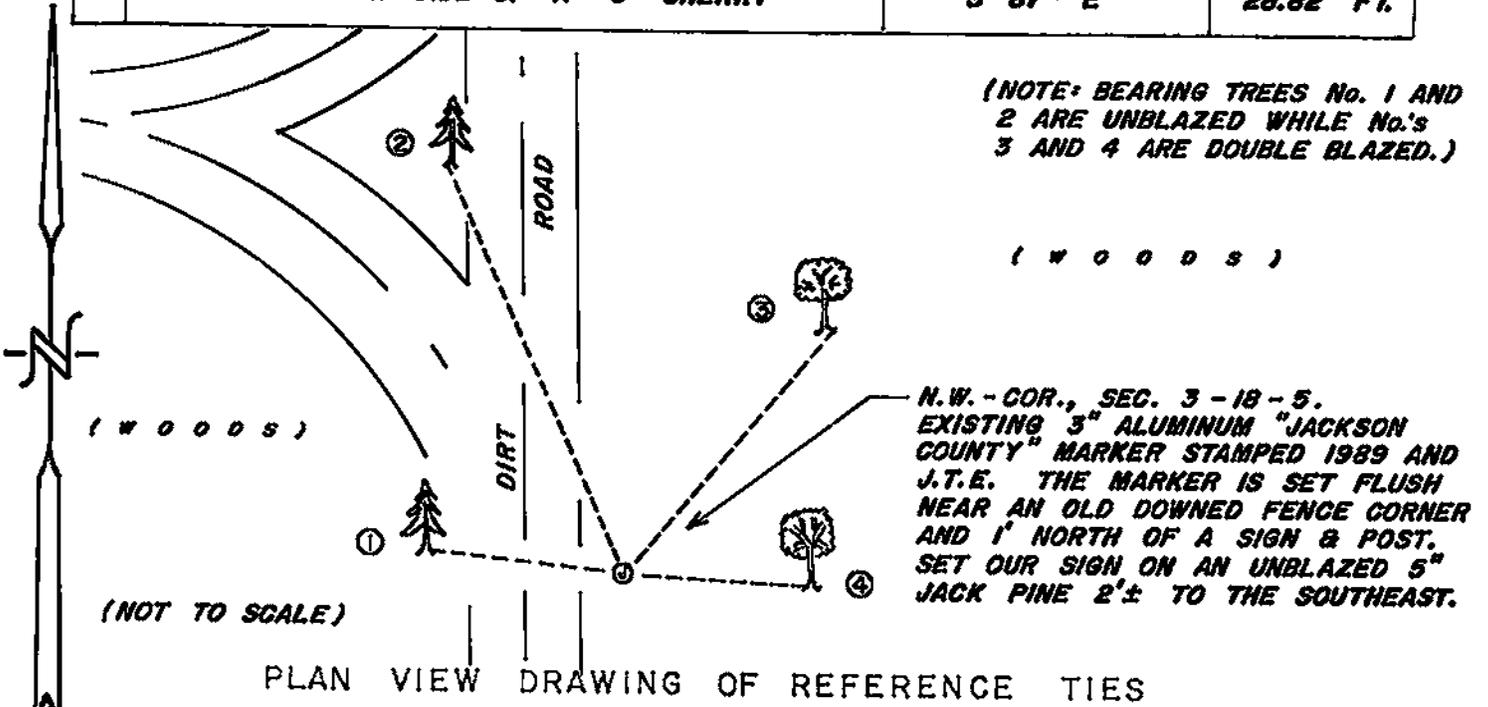

MAP SHOWING DISTANCE AND DIRECTION TO OTHER PUBLIC LAND SURVEY CORNERS USED FOR REESTABLISHING THE CORNER

(W.C. JUNG MEASUREMENTS) (1984-1985)  
(ASSUMED BEARINGS)  
(NOT TO SCALE)

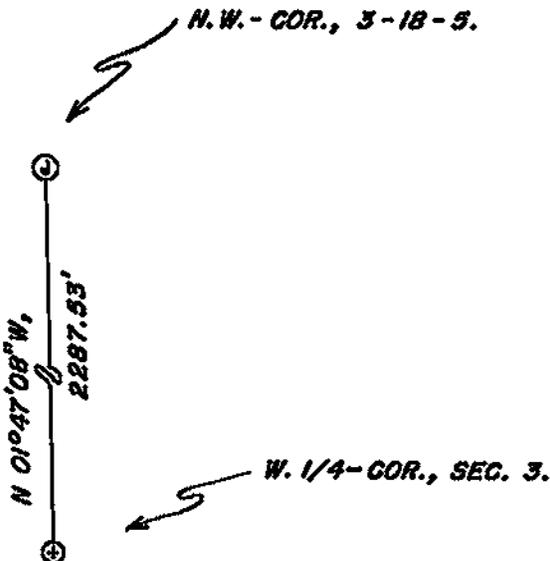

I, WILLIAM C. JUNG, COUNTY SURVEYOR  
HEREBY CERTIFY THAT THE CORNER LOCATION SHOWN ON THIS RECORD WAS DETERMINED BY ME OR UNDER MY DIRECTION AND CONTROL AND THAT THIS U. S. PUBLIC LAND SURVEY MONUMENT RECORD IS CORRECT AND COMPLETE TO THE BEST OF MY KNOWLEDGE AND BELIEF.

William C Jung  
Signature

3/15/06  
Date



Seal

**Government Land Corner Certificate**  
**Jackson County**

CORNER VOL. \_\_\_\_\_ PAGE NO. 7

CORNER # \_\_\_\_\_

SECTION 33 T 19 N, R. 5W

TYPE OF MONUMENT: 30" Berntsen Cast Aluminum

STATE PLANE COORDINATES: N \_\_\_\_\_  
 E \_\_\_\_\_


ELEVATION - M.S.L. DATUM: \_\_\_\_\_

THETA ANGLE: \_\_\_\_\_

FIELD BOOK: HSE File 82N-018

DRAWN BY: N.R. Hurlburt page \_\_\_\_\_

REFERENCED FOR SURVEY RECORDED IN: \_\_\_\_\_

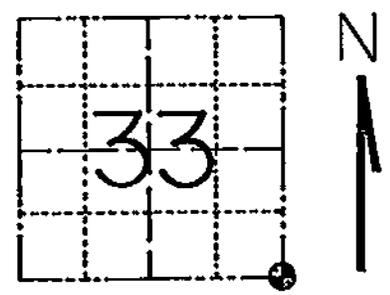

**BASIS FOR MONUMENT LOCATION**

Show info such as: History of corner, with reference to Vol. and pg., dates, surveyor; exact description of monument replaced; if location computed, by taped or EDM traverse; landowner remarks, etc. (Use reverse side if necessary)

In La Crosse County CSM 78 of Vol. 2, Clayton Solberg ties his description to this corner, but does not indicate any monument here. I found a 3/4" pipe at the fence corner with a 1/2" pipe guard stake, which I assumed to be set by him, since it is similar to other stakes (unrecorded) set by him on the approximate section line south from here. Not knowing any other history of this corner, and needing other town line corners, I proceeded to verify its position. The nearest known corners are 2 miles west, 2 miles north, and 3 miles east. There is nothing south within a reasonable distance.

I traversed to all monumented or occupied corners from the SW 31 to the SE 36. The distance from the SE 31 to the SE 36 averages 5.4 feet per half mile short of government distance. Mr. Solberg's pipe is within 2 feet of correct proportion. A straight line between the same two points falls about 170 feet North of the pipe, but the general line of occupation, especially to the east, points toward the pipe, indicating a bend in the line here.

(continued on reverse side)

LOCATION  
 (Shown by monument symbol)



SEAL:

DATA SHOWN HERE ON CERTIFIED CORRECT:

*Norman R. Hurlburt*  
 Registered Land Surveyor  
 DATE: Dec. 30, 1982

**TIE SKETCH**

Show at least four ties, also fence lines, roads, topo, size and type of witness trees and if off road - best way to arrive at corner.

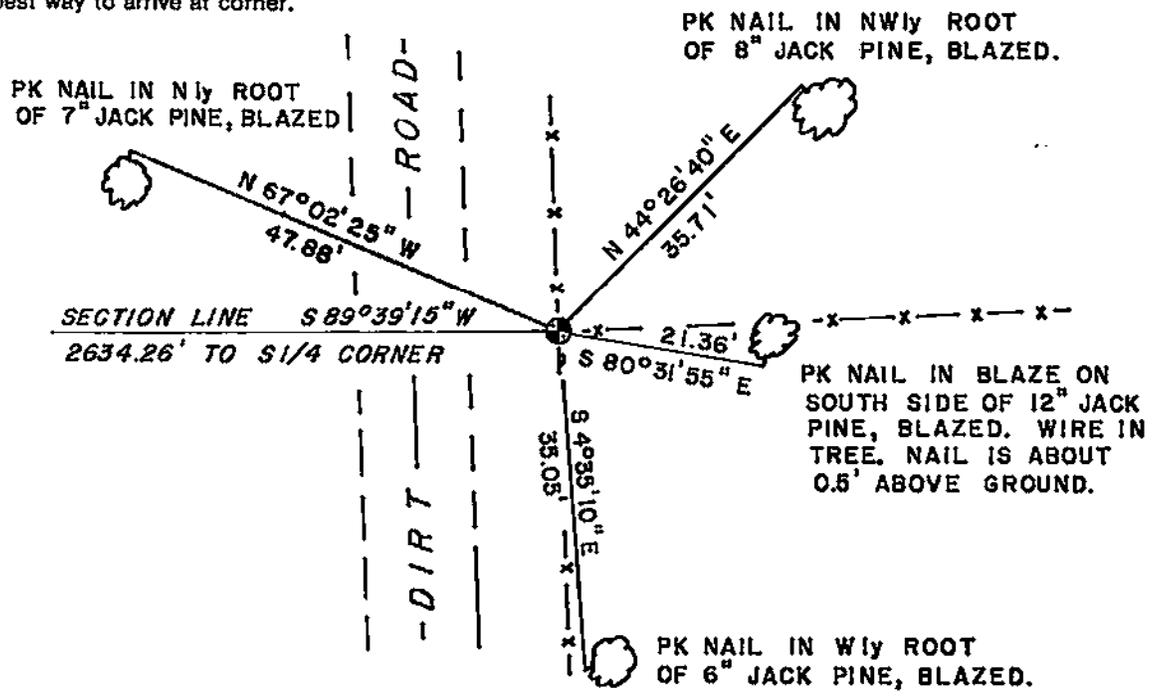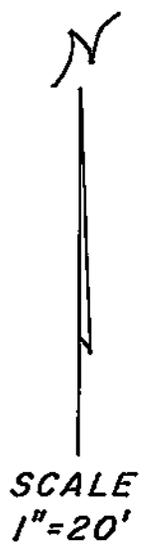

I traversed to all apparent evidence of corners along the south line of sections 1 through 6 and found this to be a reasonably straight line ( $\pm 25'$ ). Original government distances north from corners on this line indicate there was a major bend at the corner in question. The distance from Mr. Solberg's pipe to my computed corner south would be 20 to 30 feet over government distance. The distance to the monumented corner 2 miles north is about 25 feet over.

With this evidence in mind, I concluded the existing pipe to be as close to the original corner position as could be determined, and accepted it as such. I replaced the pipe with a Berntsen monument and drove a steel witness post with sign 1.0 foot South.