

Government Land Corner Certificate

Jackson County

TYPE OF MONUMENT: 30" Berntsen Cast Aluminum

STATE PLANE COORDINATES: N _____

E _____

ELEVATION — M.S.L. DATUM: _____

THETA ANGLE: _____

FIELD BOOK: HSE File 82N-018


DRAWN BY: N.R. Hurlburt page _____

REFERENCED FOR SURVEY RECORDED IN: _____

CORNER VOL. _____ PAGE NO. 8

CORNER # 21905330020

SECTION 33 T 19 N. R. 5W

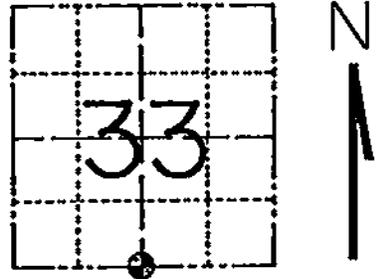

LOCATION
(Shown by monument symbol)

BASIS FOR MONUMENT LOCATION

Show info such as: History of corner, with reference to Vol. and pg., dates, surveyor; exact description of monument replaced; if location computed, by taped or EDM traverse; landowner remarks, etc. (Use reverse side if necessary)

I have found no record of this corner having been used or remonumented since the original survey. After verifying the SE corner of Section 33, I re-established this corner at proportionate distance and on a straight line corrected for curvature between there and the SW 32. (See corner certificates on SE 33 and SE 32.) This point falls about 40 feet north and 10 feet west of the fence corner. There was an east-west road here in the early 1900's, but there is little evidence of its original location now. Its past existence though, raises a question as to whether the E-W fence was ever intended to be on the township line. To adjust to the fence corner would put a major bend in the supposedly straight township line, more of a bend than I believe is reasonable.

I monumented the proportioned corner with a Berntsen, and drove a steel witness post with sign 1.0 foot North.

SEAL:



DATA SHOWN HERE ON CERTIFIED CORRECT:

Norman R. Hurlburt
Registered Land Surveyor

DATE: Dec. 30, 1982

TIE SKETCH

Show at least four ties, also fence lines, roads, topo, size and type of witness trees and if off road - best way to arrive at corner.



SCALE
1" = 60'

