


U. S. PUBLIC LAND SURVEY MONUMENT RECORD

SECTION 3 T 18 N, R 5 W, TOWN OF FARMINGTON

LA CROSSE COUNTY

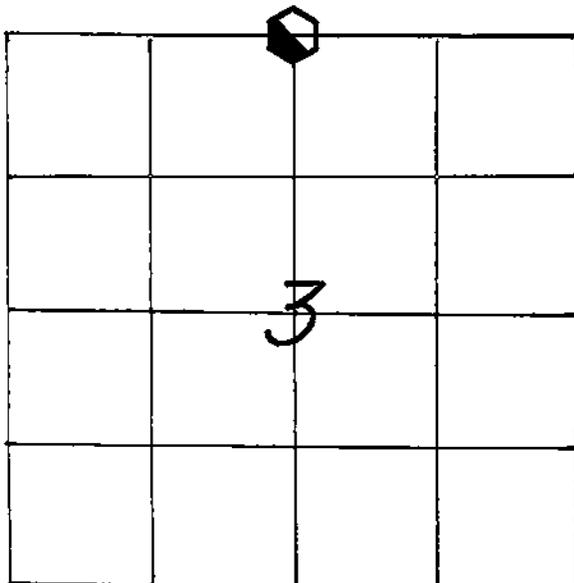

LOCATION OF LANDMARK

CREW: *WILLIAM C. JUNG*
PETER F. FOLLANSBEE
 DATE: *3/28/2005*

WISCONSIN COORDINATE SYSTEM

North

East

Theta Angle

Horiz. Order

Vert. Order

TYPE OF LANDMARK
BERNTSEN MARKER.

BEARINGS ARE REFERENCED TO

Describe any record evidence, monument evidence, testimonial evidence or any other material evidence you considered and whether the monument was found or restored through acceptance of an obliterated evidence location.


I found the Berntsen marker set by Hurlburt back in 1983 and took new ties.

Describe or show any material discrepancy between the location of the restored corner and that of the corner previously restored or reestablished.

NONE KNOWN.

RECORD OF DURABLE WITNESS MONUMENTS

NO	DESCRIPTION	MAGNETIC	
		BEARING	DISTANCE
1	SET A NAIL IN N.E.-SIDE OF A 15-1/2" OAK	N 42° W	22.59 FT.
2	SET A NAIL IN N.E.-SIDE OF A 16" OAK	N 16° W	54.68 FT.
3	SET A NAIL IN S.-SIDE OF A 17-1/2" OAK	S 80° E	18.29 FT.
4	SET A NAIL IN N.W.-SIDE OF A 17-1/2" OAK	S 12° W	23.05 FT.

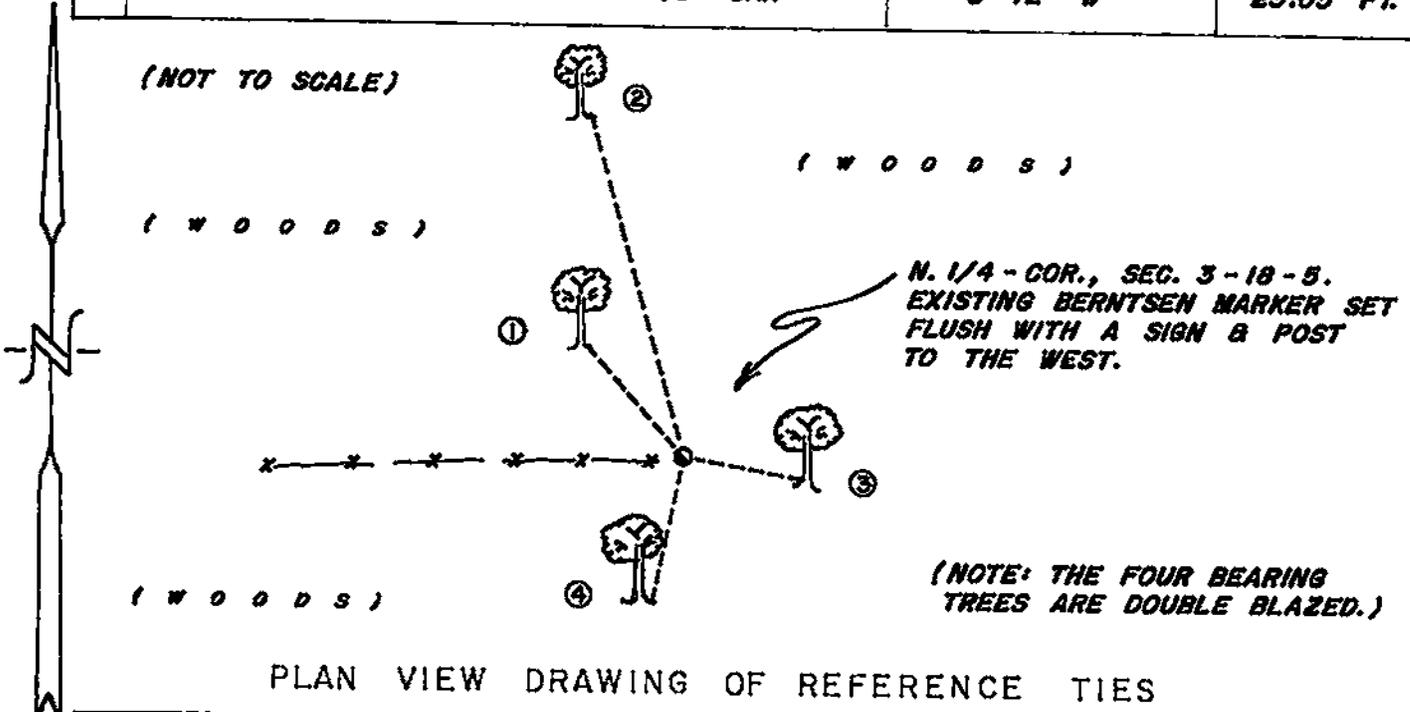

MAP SHOWING DISTANCE AND DIRECTION TO OTHER PUBLIC LAND SURVEY CORNERS USED FOR REESTABLISHING THE CORNER

(see section data of record)

I, WILLIAM C. JUNG, COUNTY SURVEYOR
 HEREBY CERTIFY THAT THE CORNER LOCATION SHOWN ON THIS RECORD
 WAS DETERMINED BY ME OR UNDER MY DIRECTION AND CONTROL AND
 THAT THIS U. S. PUBLIC LAND SURVEY MONUMENT RECORD IS CORRECT
 AND COMPLETE TO THE BEST OF MY KNOWLEDGE AND BELIEF.

William C. Jung
 Signature

3/15/06
 Date



Seal

CERTIFICATE

CERTIFIED LAND CORNER

N¹/₄ - 3 - 18-5, Farmington No. 100

I, Norman R. Hurlburt, do hereby certify that on the 25th day of JANUARY, 19 83, I found (evidence) (~~to witness~~) of the SW corner of S&W 34, T 19 N, R 5W E, Fourth Principal Meridian, and I re-established said corner according to the Wisconsin Statutes as shown and described hereon.

Dated this 4th day of May, 19 83.

Norman R. Hurlburt

Norman R. Hurlburt Title 5-1104


Description of corner and witness monuments, references and accessories used to perpetuate the original or re-established location of this corner:

Witnesses to corner location:

N. Hurlburt



D. Melichar

Ray Pelishak

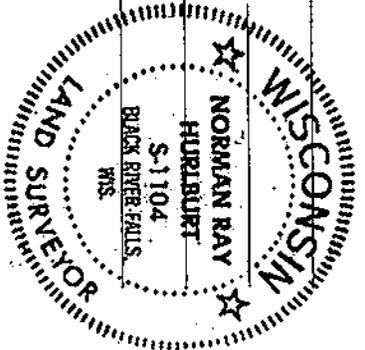

History of original corner establishment:
Clayton Solberg used this corner in La Crosse County GSN No. 78 of Vol. 2, and set a pipe.

Description of corner evidence found:
I found Solberg's pipe (5/8") and replaced it with a La Crosse County Monument. This position fits line and proportional distance east and west quite well.

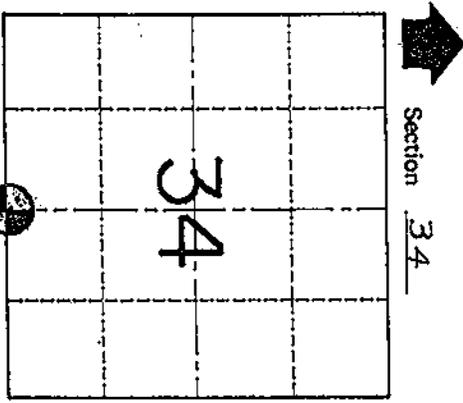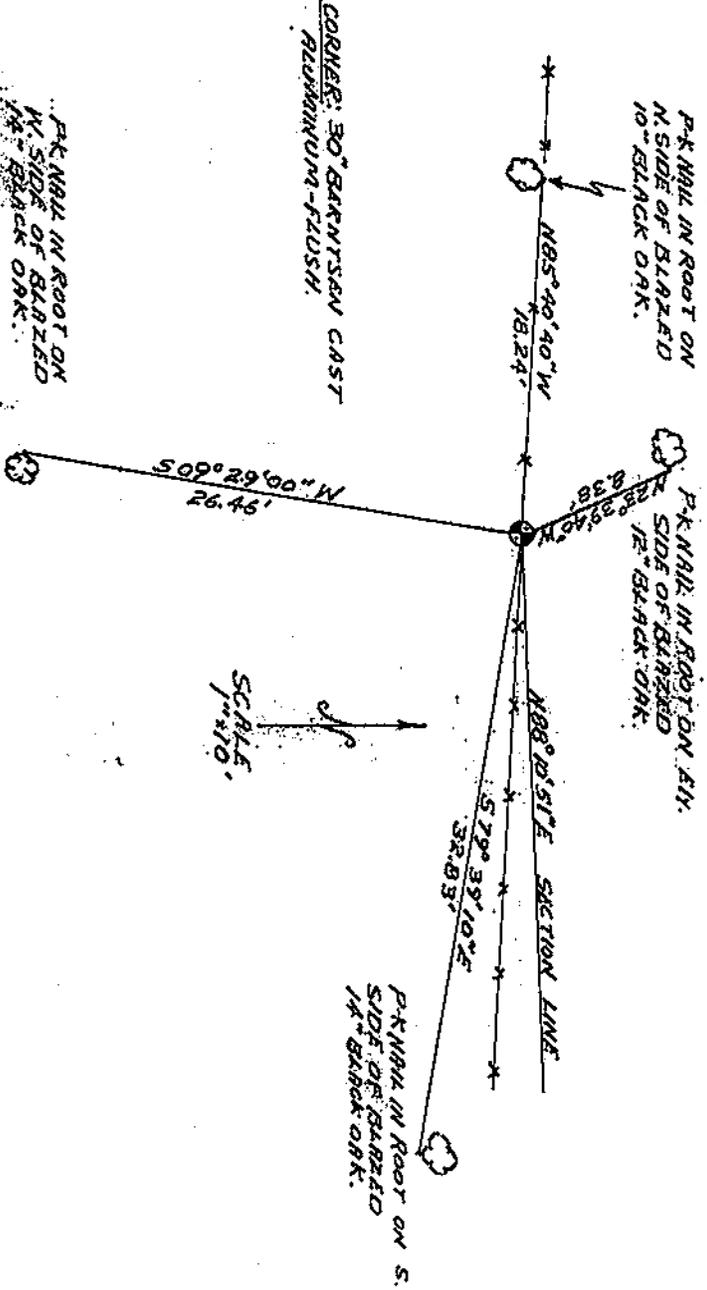

SURVEY CONTROL ORDER

Horizontal		East (X)		Elevation (Z)	
Vertical					
Corner					
Control Sta. Name					

WISCONSIN COORDINATE SYSTEM

GREYVINE or TOWN Little Falls

County of MEAD

Section 34
T 19 N R 5W
WISCONSIN