


## U. S. PUBLIC LAND SURVEY MONUMENT RECORD

SECTION 1 T 18 N, R 6 W, TOWN OF FARMINGTON

LA CROSSE COUNTY

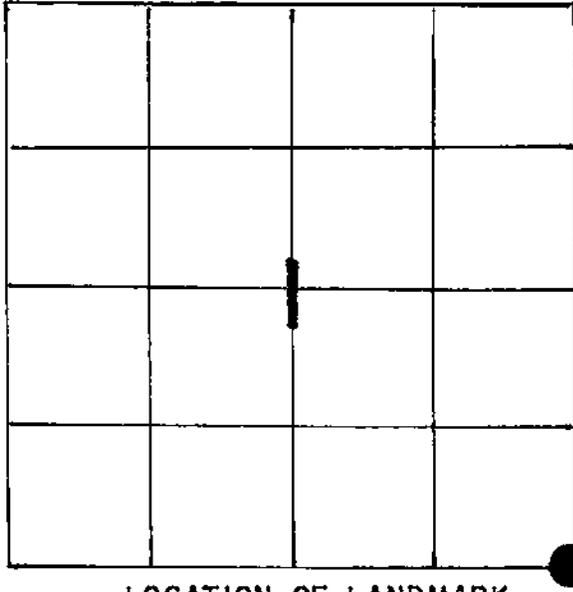

LOCATION OF LANDMARK

Crew: William Jung  
Perry Dahl

4/26/85

## WISCONSIN COORDINATE SYSTEM

North

East

Theta Angle

Horiz. Order

Vert. Order

TYPE OF LANDMARK  
BERNTSENBEARINGS ARE REFERENCED TO  
Assumed

Describe any record evidence, monument evidence, testimonial evidence or any other material evidence you considered and whether the monument was found or restored through acceptance of an obliterated evidence location.

Norm Hurlburt found a nail at the occupied corner and accepted it as the best available evidence of the original government corner. I believe that this point has been used in other surveys, probably by Berg, and also by the late Mr. Beekman, who did a survey for Seils to the Southeast. I removed the broken P.K. nail and replaced it with a Berntsen.

Describe or show any material discrepancy between the location of the restored corner and that of the corner previously restored or reestablished.

None known.

