


21806010020

U. S. PUBLIC LAND SURVEY MONUMENT RECORD

SECTION 1 T 18 N, R 6 W, TOWN OF FARMINGTON

LA CROSSE COUNTY

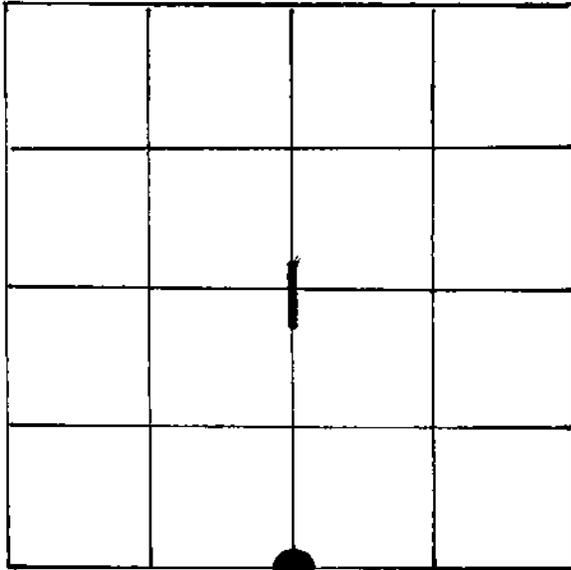

LOCATION OF LANDMARK

Crew: William Jung
 Perry Dahl
 4/26/85

WISCONSIN COORDINATE SYSTEM

North

East

Theta Angle

Horiz. Order

Vert. Order

TYPE OF LANDMARK

RAILROAD SPIKE

BEARINGS ARE REFERENCED TO

Describe any record evidence, monument evidence, testimonial evidence or any other material evidence you considered and whether the monument was found or restored through acceptance of an obliterated evidence location.


In April of 1976 Fred Kraft shows the corner as being at the road intersection. Norm Hurlburt found a nail at the intersection and accepted it as the best available evidence of the original government corner. I removed the nail and replaced it with a railroad spike.

Describe or show any material discrepancy between the location of the restored corner and that of the corner previously restored or reestablished.

None known.

RECORD OF DURABLE WITNESS MONUMENTS

NO	DESCRIPTION	BEARING	DISTANCE
1	UTILITY BOX (to Southeast corner)	N55°W	61.70'
2	NAIL IN 6" UNBLAZED NORWAY PINE TREE	S26°E	80.57'
3	U.S.G.S. MARKER WITH SIGN	N74°E	127.79'
4	SET IRON PIPE WITH 1½" TOP (flush)	North±	58.35'

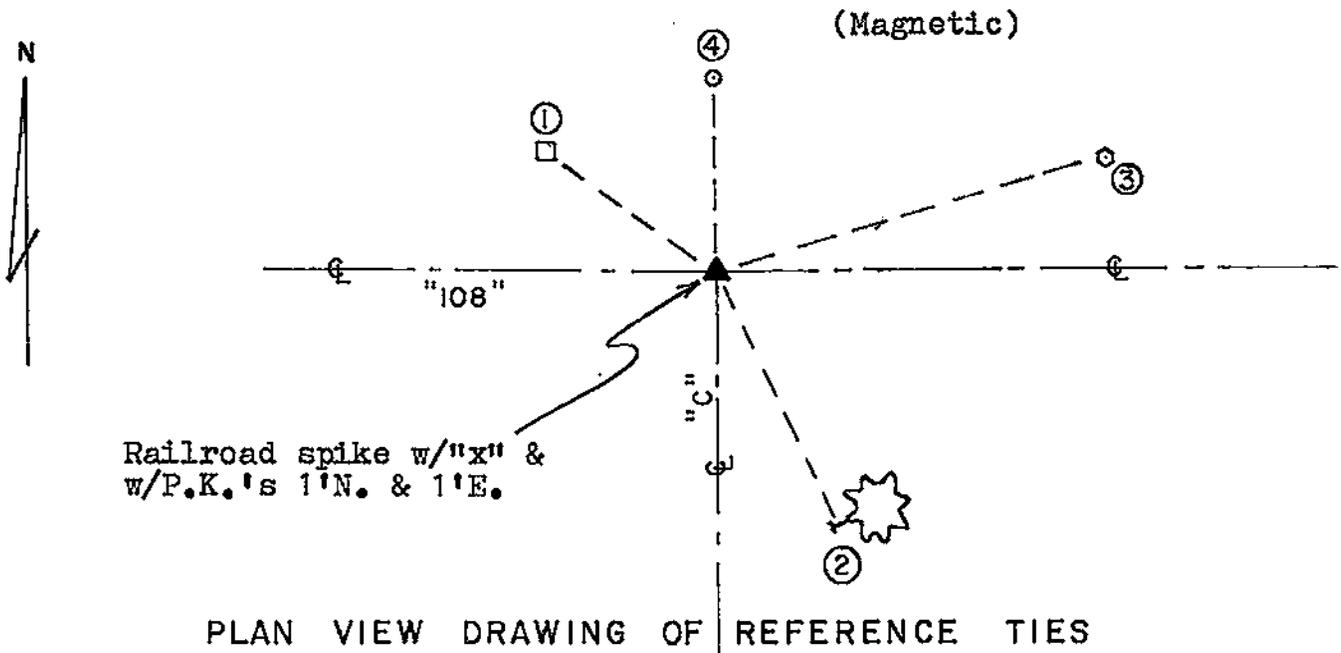


MAP SHOWING DISTANCE AND DIRECTION TO OTHER PUBLIC LAND SURVEY CORNERS USED FOR REESTABLISHING THE CORNER

None measured by me. See Hurlburt map, dated 4/25/85.

I, William C. Jung, Deputy County Surveyor,
 HEREBY CERTIFY THAT THE CORNER LOCATION SHOWN ON THIS RECORD
 WAS DETERMINED BY ME OR UNDER MY DIRECTION AND CONTROL AND
 THAT THIS U. S. PUBLIC LAND SURVEY MONUMENT RECORD IS CORRECT
 AND COMPLETE TO THE BEST OF MY KNOWLEDGE AND BELIEF.

William C. Jung
 Signature

2/6/86
 Date

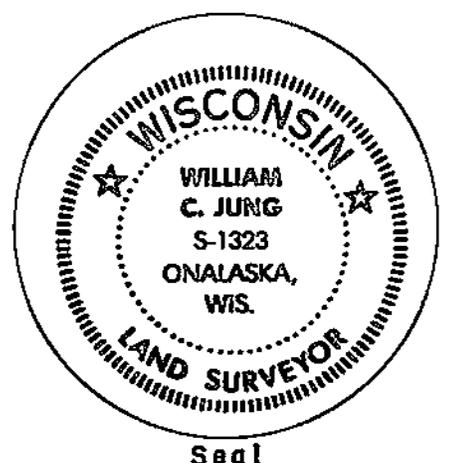

Seal