


U. S. PUBLIC LAND SURVEY MONUMENT RECORD

SECTION 1 T 18 N, R 6 W, TOWN OF Farmington

LA CROSSE COUNTY

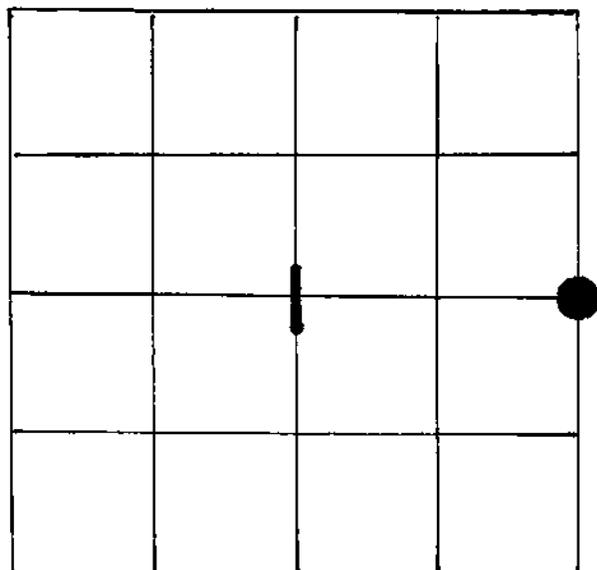

LOCATION OF LANDMARK

Crew: William Jung
 Perry Dahl
 4/26/85

WISCONSIN COORDINATE SYSTEM
North
East
Theta Angle
Horiz. Order
Vert. Order
TYPE OF LANDMARK
Berntsen
BEARINGS ARE REFERENCED TO
Assumed

Describe any record evidence, monument evidence, testimonial evidence or any other material evidence you considered and whether the monument was found or restored through acceptance of an obliterated evidence location.


Clayton Solberg shows ties to this corner in two 1978 surveys and in August of 1981 shows a 2" iron pipe at the corner. Norm Hurlburt found a nail at the corner but no pipe. He accepted the nail at the fence corner as the best available evidence of the original government corner. I removed the nail and replaced it with a Berntsen monument. I also could not find a pipe.

Describe or show any material discrepancy between the location of the restored corner and that of the corner previously restored or reestablished.

None known.

RECORD OF DURABLE WITNESS MONUMENTS

NO	DESCRIPTION	BEARING	DISTANCE
1	NAIL IN UNBLAZED 10" JACK PINE (nail in base)	S38-35-55W	51.84'
2	1" IRON PIPE (existing)	S01-51-35E	173.65'
3	CORNER OF UTILITY BOX	S87-25-05E	23.00'
4			

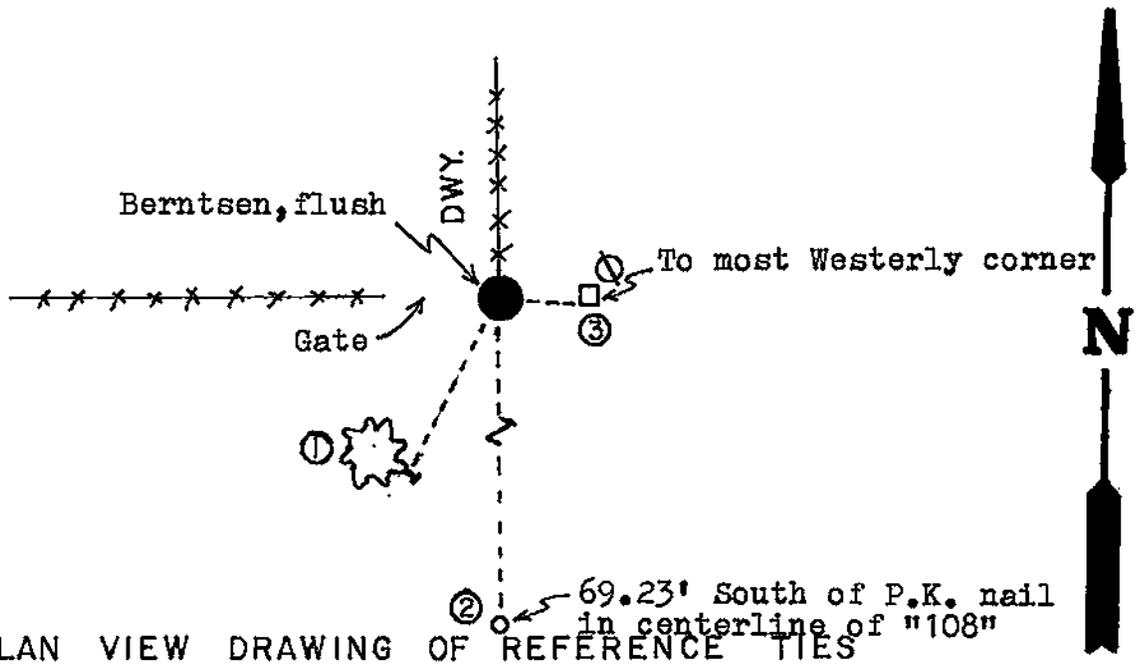

MAP SHOWING DISTANCE AND DIRECTION TO OTHER PUBLIC LAND SURVEY CORNERS USED FOR REESTABLISHING THE CORNER

None measured by me. See Hurlburt map, 4/25/85.

I, William C. Jung, Deputy County Surveyor,
 HEREBY CERTIFY THAT THE CORNER LOCATION SHOWN ON THIS RECORD
 WAS DETERMINED BY ME OR UNDER MY DIRECTION AND CONTROL AND
 THAT THIS U. S. PUBLIC LAND SURVEY MONUMENT RECORD IS CORRECT
 AND COMPLETE TO THE BEST OF MY KNOWLEDGE AND BELIEF.

William C. Jung
 Signature

2/6/86
 Date



Seal