


U. S. PUBLIC LAND SURVEY MONUMENT RECORD

SECTION 1 T 18 N, R 6 W, TOWN OF FARMINGTON
 LA CROSSE COUNTY

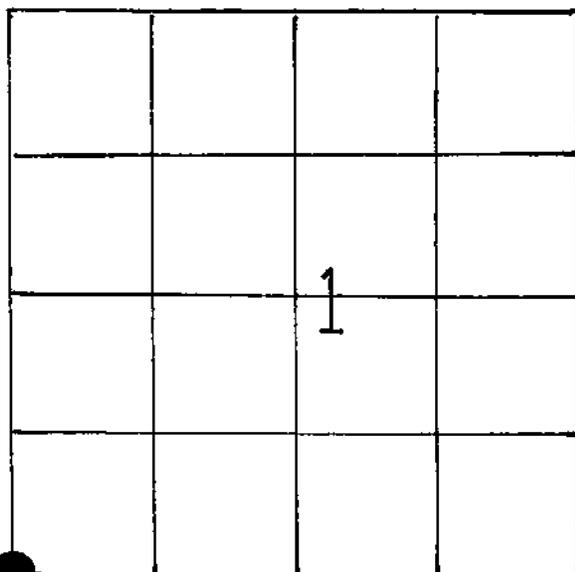

LOCATION OF LANDMARK

Crew: William Jung
 Perry Dahl

5/22/87

Describe any record evidence, monument evidence, testimonial evidence or any other material evidence you considered and whether the monument was found or restored through acceptance of an obliterated evidence location.

I set the corner at a location computed out by Norm Hurlburt and monumented it with a brass capped Lunde marker, down 3" in the lawn.


Describe or show any material discrepancy between the location of the restored corner and that of the corner previously restored or reestablished.

NONE KNOWN

WISCONSIN COORDINATE SYSTEM
North
East
Theta Angle
Horiz. Order
Vert. Order
TYPE OF LANDMARK
SET BRASS CAP LUNDE MARKER
BEARINGS ARE REFERENCED TO
ASSUMED

RECORD OF DURABLE WITNESS MONUMENTS

NO	DESCRIPTION	BEARING	DISTANCE
1	SET RAILROAD SPIKE IN CENTERLINE S.T.H. 108	NORTH ±	28.33 Ft.
2	SET 1 1/4" IRON PIPE ON TOP OF CREEK BANK	SOUTH±±	21.23 Ft.
3	CENTER OF STEEL POST FOR BAR SIGN	MAG. = S 74 E	102.10 Ft.
4	NORTHWEST CORNER OF TAVERN	MAG. = S 80 E	173.35 Ft.

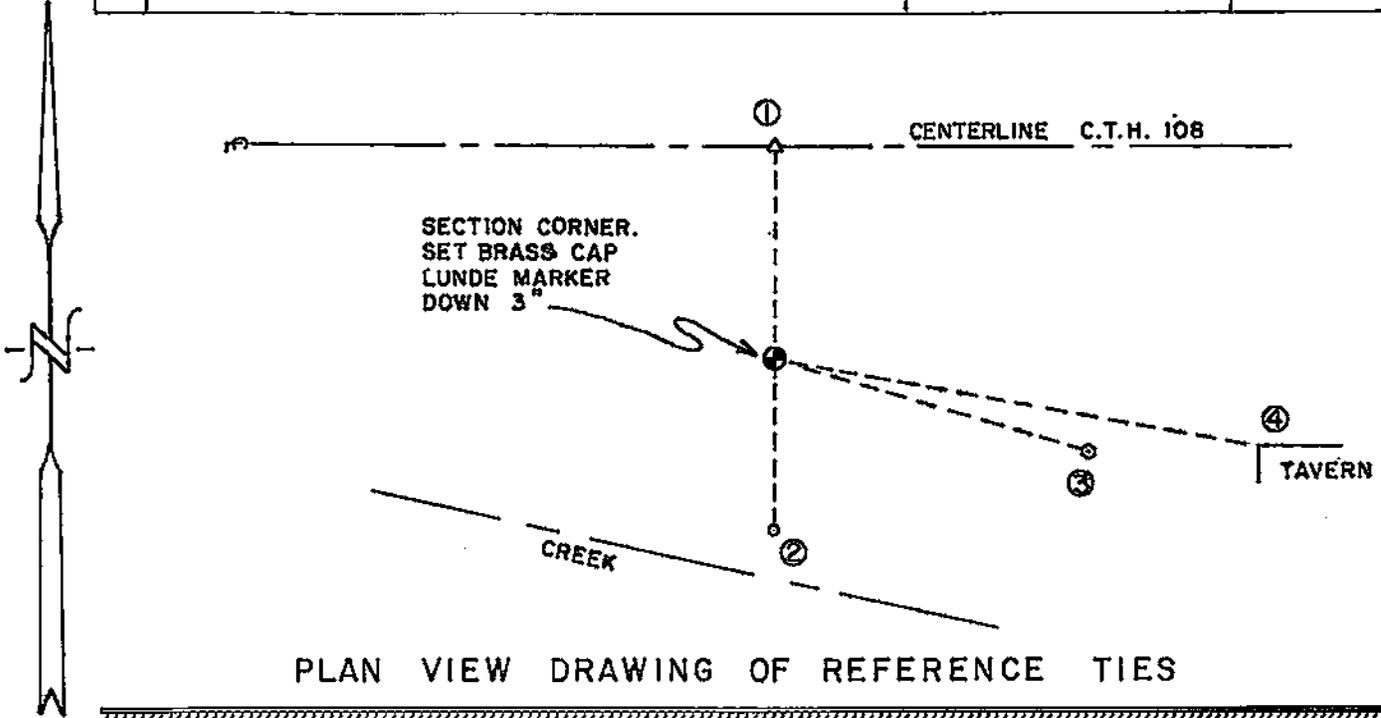


PLAN VIEW DRAWING OF REFERENCE TIES

MAP SHOWING DISTANCE AND DIRECTION TO OTHER PUBLIC LAND SURVEY CORNERS USED FOR REESTABLISHING THE CORNER


(NOT TO SCALE)

(HURLBURT MEASUREMENTS)

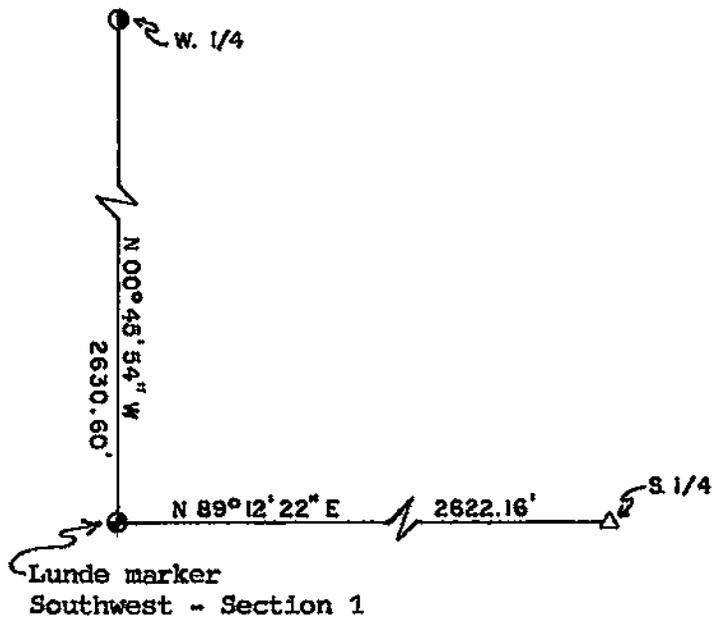

I, WILLIAM C. JUNG
 HEREBY CERTIFY THAT THE CORNER LOCATION SHOWN ON THIS RECORD
 WAS DETERMINED BY ME OR UNDER MY DIRECTION AND CONTROL AND
 THAT THIS U. S. PUBLIC LAND SURVEY MONUMENT RECORD IS CORRECT
 AND COMPLETE TO THE BEST OF MY KNOWLEDGE AND BELIEF.

William C. Jung Deputy County Surveyor, December 15, 1987
 Signature Date

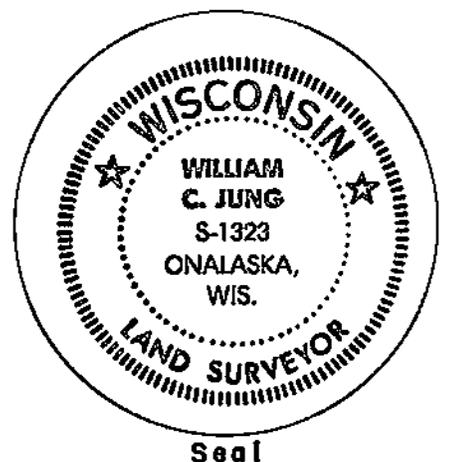

Seal