


U. S. PUBLIC LAND SURVEY MONUMENT RECORD

SECTION 2 T 18 N, R 6 W, TOWN OF FARMINGTON
 LA CROSSE COUNTY

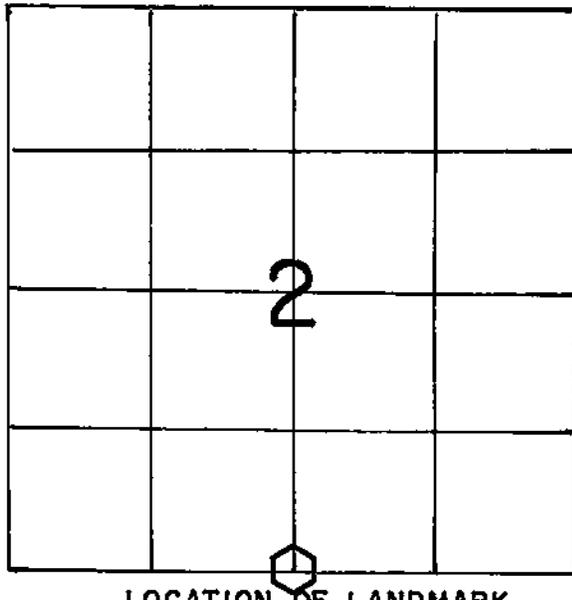

LOCATION OF LANDMARK

Crew: WILLIAM C. JUNG
 PETER F. FOLLANSBEE

Date: 5/25/1994

Describe any record evidence, monument evidence, testimonial evidence or any other material evidence you considered and whether the monument was found or restored through acceptance of an obliterated evidence location.

I set the corner off of an old stump which I believe to be the original bearing tree stump. I set a Lunde marker at the corner.

Describe or show any material discrepancy between the location of the restored corner and that of the corner previously restored or reestablished.

None Known.

WISCONSIN COORDINATE SYSTEM

North

East

Theta Angle

Horiz. Order

Vert. Order

TYPE OF LANDMARK

Set brass cap Lunde marker.

BEARINGS ARE REFERENCED TO

Assumed North.

