


U. S. PUBLIC LAND SURVEY MONUMENT RECORD

SECTION 10 T 18 N, R 6 W, TOWN OF FARMINGTON

LA CROSSE COUNTY

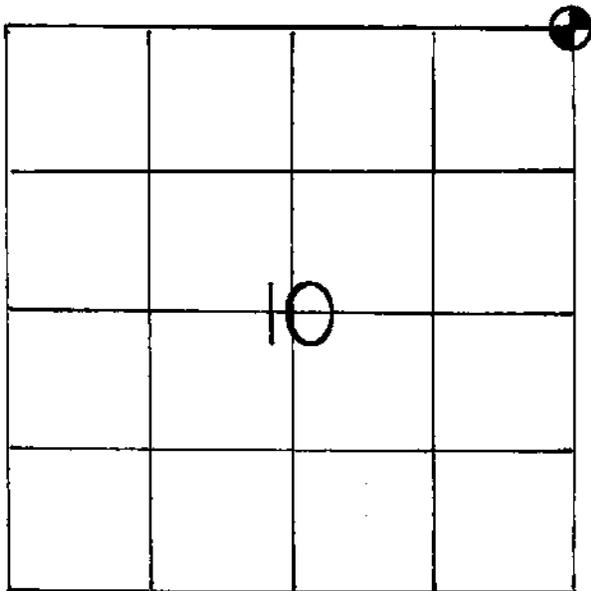

LOCATION OF LANDMARK

CREW: BILL JUNG
PERRY DAHL
DATE: 10-22-85

Crew: William C. Jung
Peter Follansbee
Date: 3-28-94

WISCONSIN COORDINATE SYSTEM

North
East
Theta Angle
Horiz. Order
Vert. Order

TYPE OF LANDMARK Lunde marker
~~1/2" X 10" BOLT WITH 1 1/4" ROUND TOP~~

BEARINGS ARE REFERENCED TO

Assumed

Describe any record evidence, monument evidence, testimonial evidence or any other material evidence you considered and whether the monument was found or restored through acceptance of an obliterated evidence location.

Dennis Melichar (with Norm Hurlburt's firm) found at the corner a 1/2"x29" rod with stones around it at a depth of 2 feet. They accepted this as the corner after analyzing their traverse computations. I agree with this position. I set a 1/2"x10" bolt with a 1 1/4" round top over the existing rod. The corner has P.K. nail offsets, 2' North and 2' East.

3-28-94 On this date I replaced the bolt with a brass capped Lunde marker.


Describe or show any material discrepancy between the location of the restored corner and that of the corner previously restored or reestablished.

None known.

RECORD OF DURABLE WITNESS MONUMENTS

NO	DESCRIPTION	BEARING	DISTANCE
1	P.K. NAIL IN DOUBLE BLAZED 11" NORWAY PINE	N47°E = Mag.	68.80'
2	P.K. NAIL IN DOUBLE BLAZED 12" NORWAY PINE	N21°E = Mag.	49.04'
3	1½" IRON PIPE (w/sign and post on North side)	NORTH ±	40.00'
4	1½" IRON PIPE	SOUTH ±	27.00'

(P.K. nail is actually on SE side of tree) WOODS (P.K.'s in trees are in hacks.)

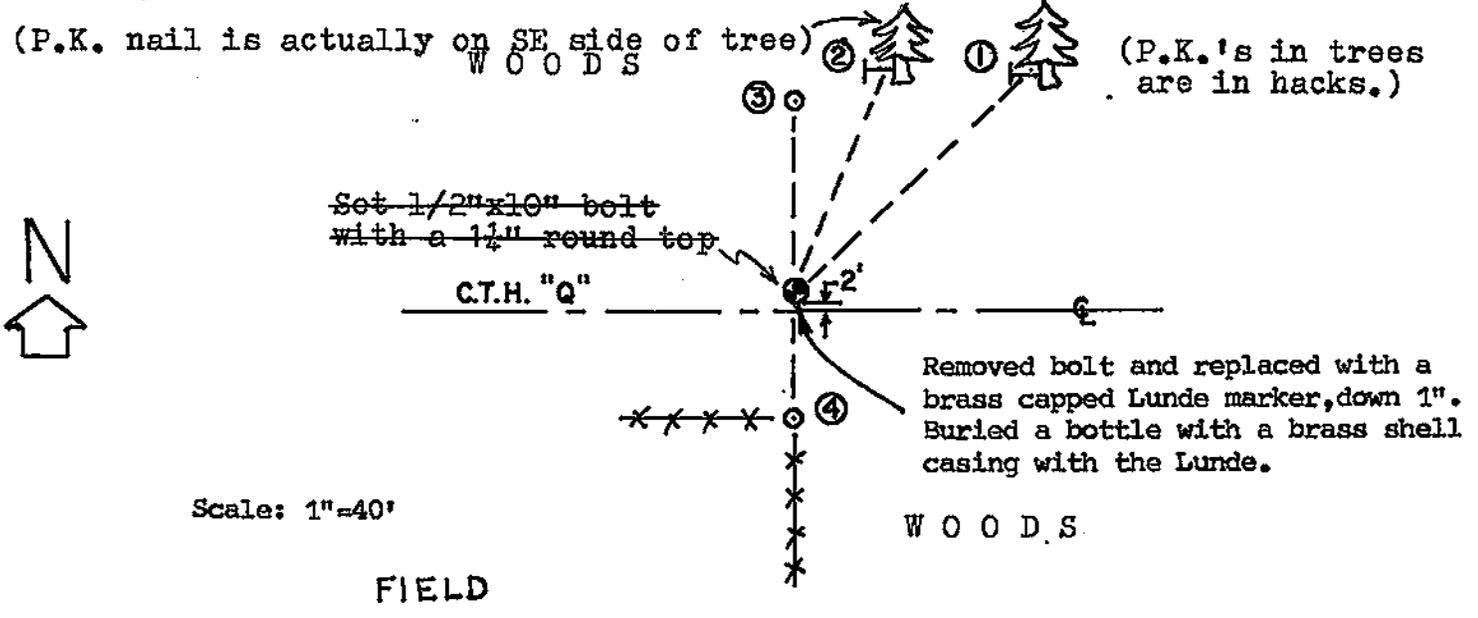


PLAN VIEW DRAWING OF REFERENCE TIES

MAP SHOWING DISTANCE AND DIRECTION TO OTHER PUBLIC LAND SURVEY CORNERS USED FOR REESTABLISHING THE CORNER

~~None measured by me at this time.~~

(not to scale)

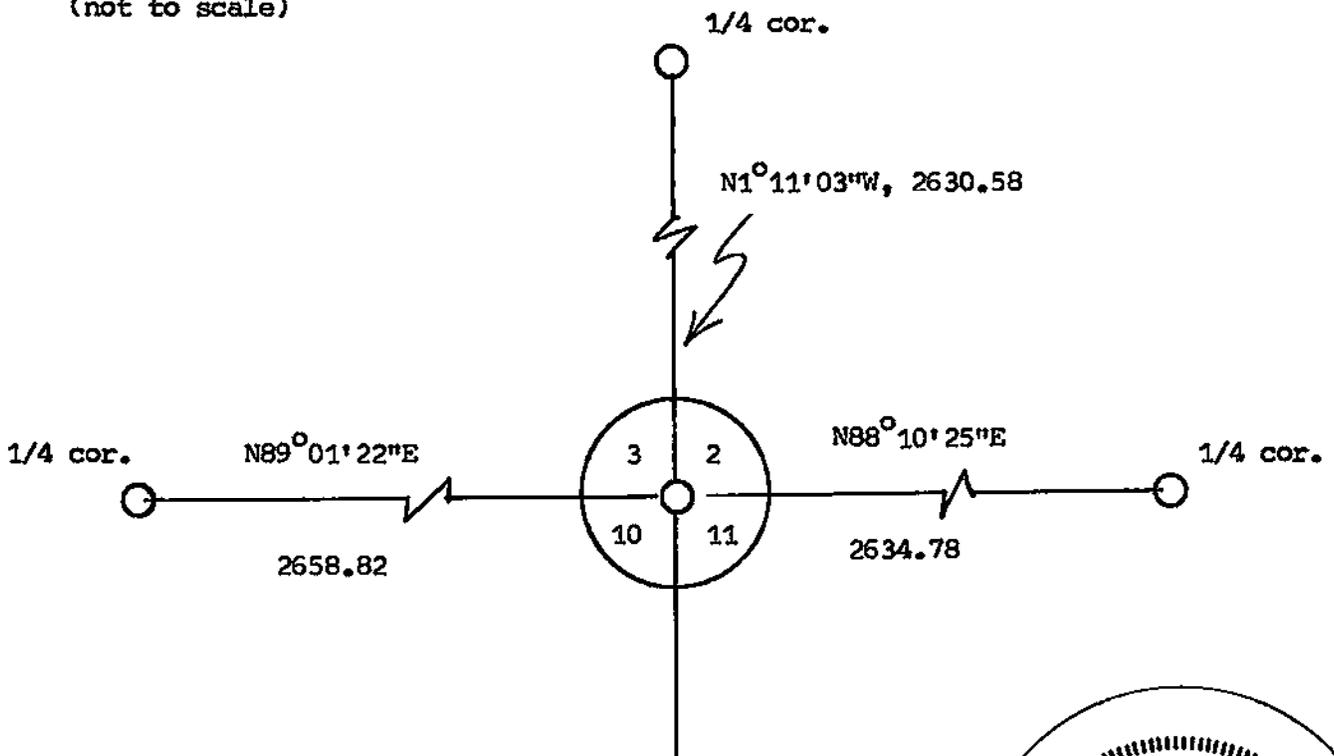


I, William C. Jung, Deputy County Surveyor,
 HEREBY CERTIFY THAT THE CORNER LOCATION SHOWN ON THIS RECORD
 WAS DETERMINED BY ME OR UNDER MY DIRECTION AND CONTROL AND
 THAT THIS U. S. PUBLIC LAND SURVEY MONUMENT RECORD IS CORRECT
 AND COMPLETE TO THE BEST OF MY KNOWLEDGE AND BELIEF.

William C. Jung
 Signature

2/7/86
 Date

Revised: 6/15/94

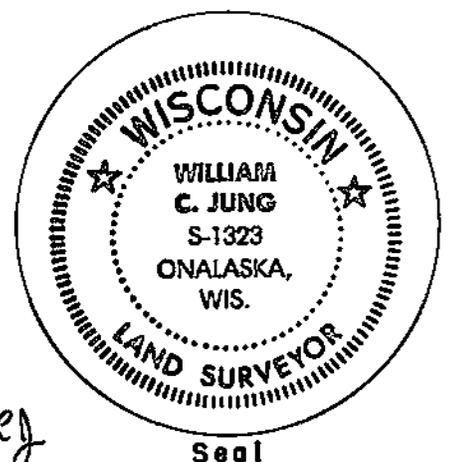

wcj