


21806032020

U. S. PUBLIC LAND SURVEY MONUMENT RECORD

SECTION 3 T 18 N, R 6 W, TOWN OF FARMINGTON

LA CROSSE COUNTY

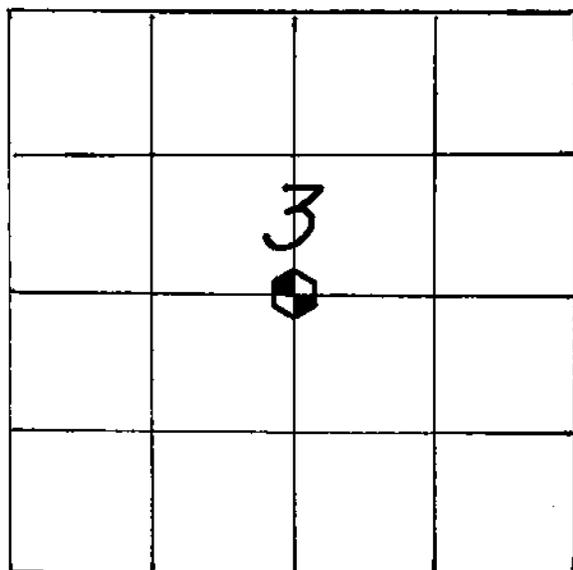

LOCATION OF LANDMARK

Crew: WILLIAM C. JUNG

PETER F. FOLLANSBEE

Date: 6/19/1996

WISCONSIN COORDINATE SYSTEM

North

East

Theta Angle

Horiz. Order

Vert. Order

TYPE OF LANDMARK

Brass cap Lunde marker.

BEARINGS ARE REFERENCED TO

Assumed

Describe any record evidence, monument evidence, testimonial evidence or any other material evidence you considered and whether the monument was found or restored through acceptance of an obliterated evidence location.

I set the corner "by law" at the intersection of the 1/4 lines.

Describe or show any material discrepancy between the location of the restored corner and that of the corner previously restored or reestablished.

NONE KNOWN.


**RECORD OF DURABLE WITNESS MONUMENTS
ASSUMED**

NO	DESCRIPTION	BEARING	DISTANCE
1	Set P.K. Nail in S.W.-side 18" Burr Oak	N 40° 50' W	19.41 Ft.
2	Set P.K. Nail in S.W.-side 20" Oak	N 07° 19' W	64.83 Ft.
3	Set P.K. Nail in N.W.-side 7" Oak	N 76° 42' E	33.54 Ft.
4	Set 1" Iron Pipe in trail	S 78° 03' E	66.08 Ft.

(Not to scale)

① ② and ③ are double blazed

C. 1/4-Cor., Sec. 3-18-6.
Set brass cap Lunde marker flush with ground. Buried a liquor bottle containing a shell casing with the marker. Set a sign & post to the S.E.

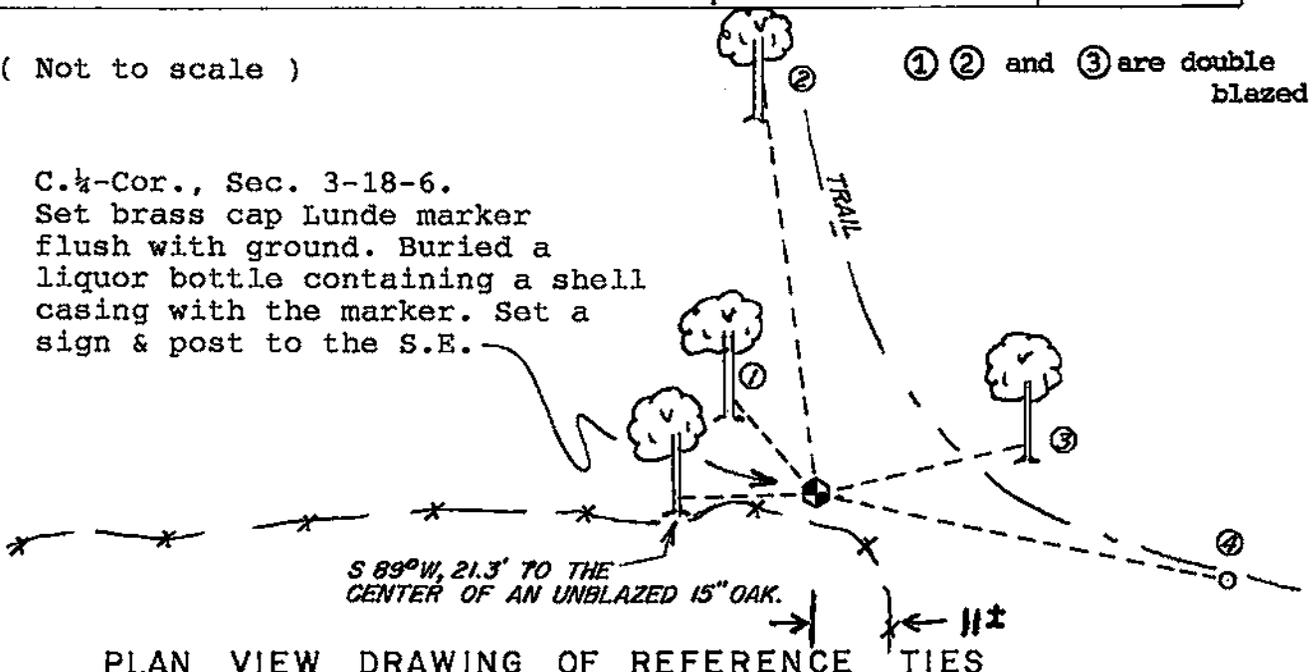


S 89°W, 21.3' TO THE CENTER OF AN UNBLAZED 15" OAK.

PLAN VIEW DRAWING OF REFERENCE TIES

MAP SHOWING DISTANCE AND DIRECTION TO OTHER PUBLIC LAND SURVEY CORNERS USED FOR REESTABLISHING THE CORNER

(not to scale)

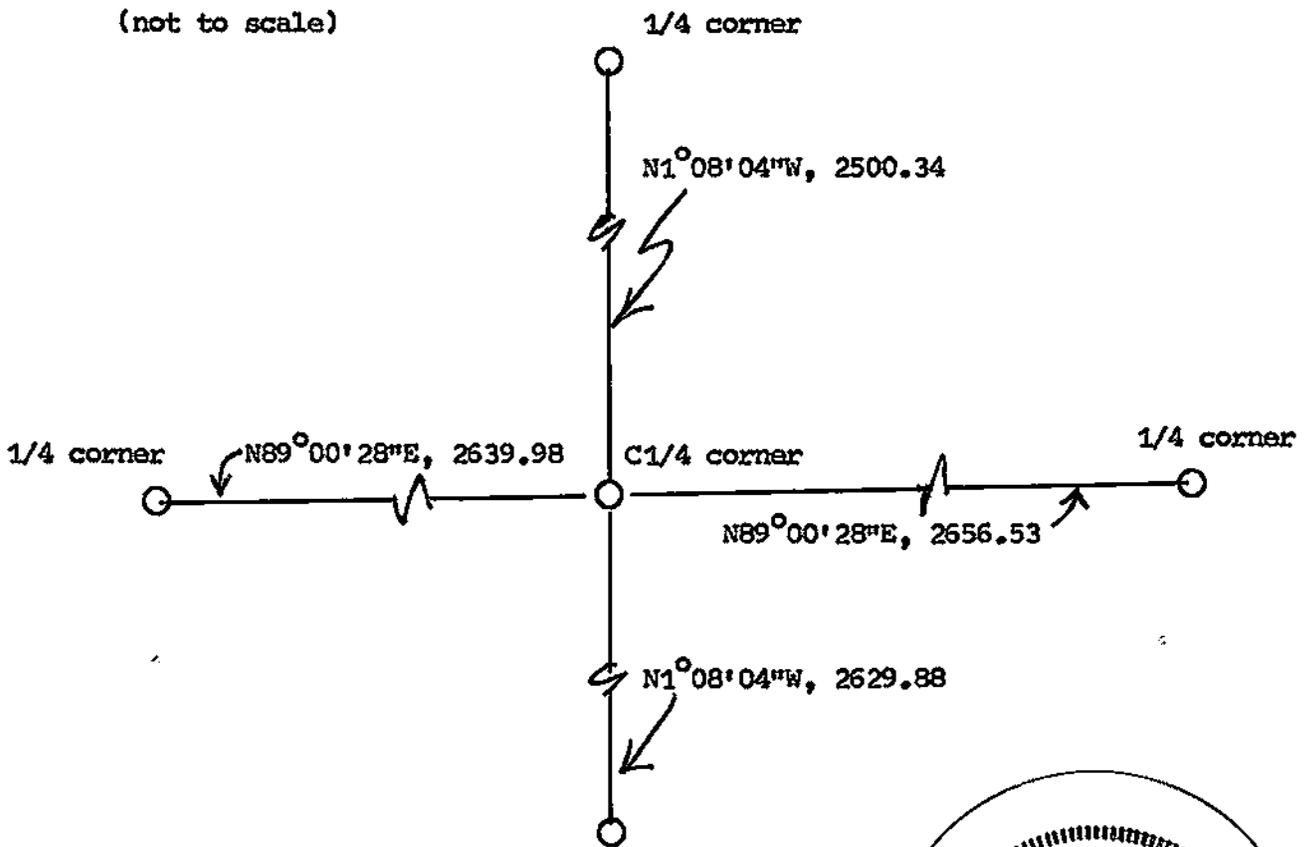

I, William C. Jung, County Surveyor
HEREBY CERTIFY THAT THE CORNER LOCATION SHOWN ON THIS RECORD WAS DETERMINED BY ME OR UNDER MY DIRECTION AND CONTROL AND THAT THIS U. S. PUBLIC LAND SURVEY MONUMENT RECORD IS CORRECT AND COMPLETE TO THE BEST OF MY KNOWLEDGE AND BELIEF.

William C. Jung 1/2/97
Signature Date



Seal