


U. S. PUBLIC LAND SURVEY MONUMENT RECORD

SECTION 4 T 18 N, R 6 W, TOWN OF FARMINGTON

LA CROSSE COUNTY

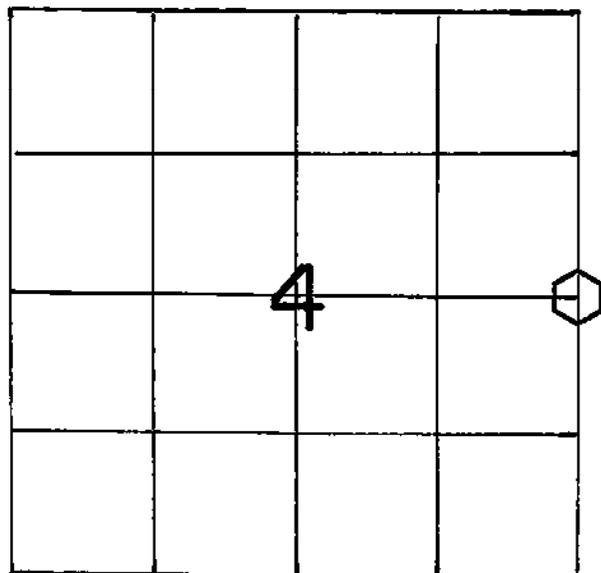

LOCATION OF LANDMARK

WISCONSIN COORDINATE SYSTEM
North
East
Theta Angle
Horiz. Order
Vert. Order
TYPE OF LANDMARK
Set brass cap Lunde marker.
BEARINGS ARE REFERENCED TO
Assumed North

Crew: WILLIAM C. JUNG  
 PETER F. FOLLANSBEE

Date: 5/16/1994

Describe any record evidence, monument evidence, testimonial evidence or any other material evidence you considered and whether the monument was found or restored through acceptance of an obliterated evidence location.


I set this corner by single proportionate measurement and monumented it with a brass capped Lunde marker. The corner fell under an East-West fence.

Describe or show any material discrepancy between the location of the restored corner and that of the corner previously restored or reestablished.

None Known.


RECORD OF DURABLE WITNESS MONUMENTS

NO	DESCRIPTION	MAGNETIC	
		BEARING	DISTANCE
1	Set P.K. Nail in SW-side 7" Cedar	N 66° W	75.64 Ft.
2	Set P.K. Nail in NE-side 5" Oak	N 24° W	48.33 Ft.
3	Set P.K. Nail in S.-side 7" Jack Pine	N 84° E	81. = 130.72'
4	Set P.K. Nail in NW-side 9" Jack Pine	S 16° W	127.32 Ft.

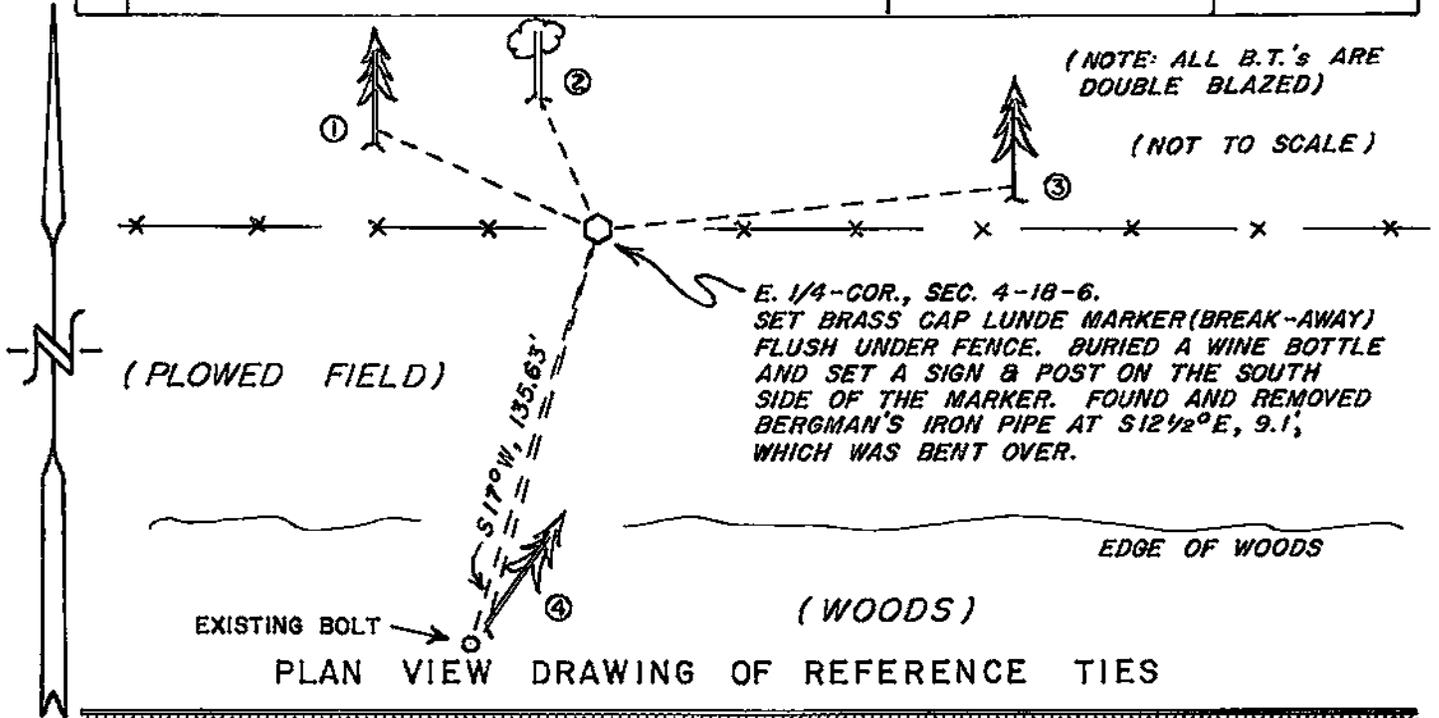


MAP SHOWING DISTANCE AND DIRECTION TO OTHER PUBLIC LAND SURVEY CORNERS USED FOR REESTABLISHING THE CORNER

(not to scale)

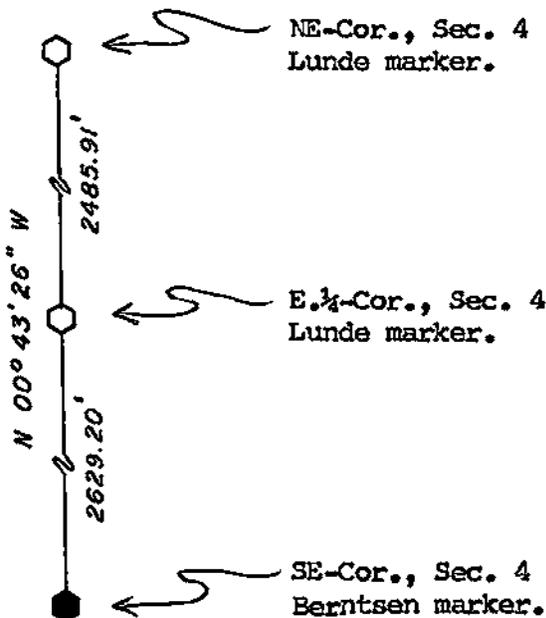

I, William C. Jung, County Surveyor  
HEREBY CERTIFY THAT THE CORNER LOCATION SHOWN ON THIS RECORD WAS DETERMINED BY ME OR UNDER MY DIRECTION AND CONTROL AND THAT THIS U. S. PUBLIC LAND SURVEY MONUMENT RECORD IS CORRECT AND COMPLETE TO THE BEST OF MY KNOWLEDGE AND BELIEF.

William C. Jung 6/14/94  
Signature Date

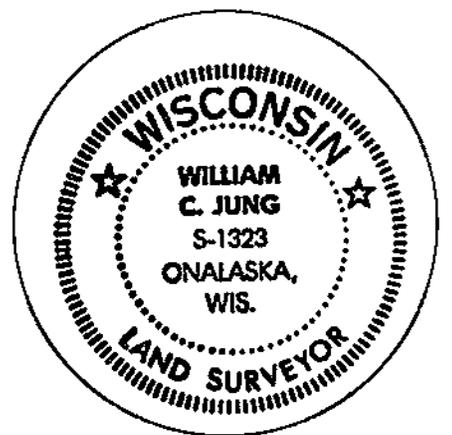

Seal