


## U. S. PUBLIC LAND SURVEY MONUMENT RECORD

SECTION 9 T 18 N, R 6 W, TOWN OF FARMINGTON  
LA CROSSE COUNTY

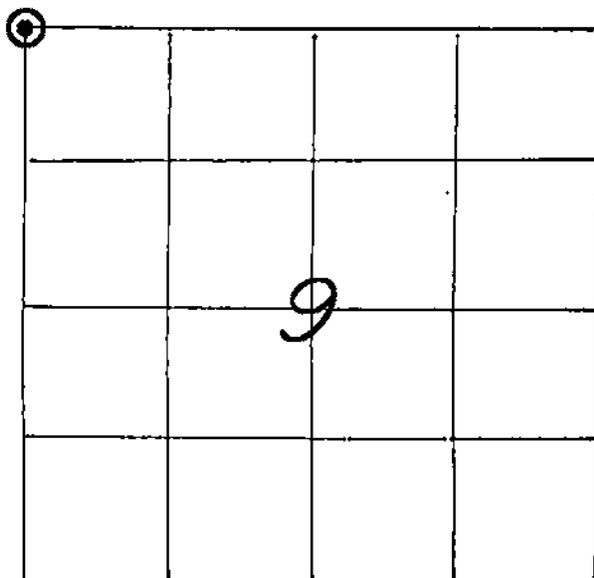

WISCONSIN COORDINATE SYSTEM
North
East
Theta Angle
Horiz. Order
Vert. Order
TYPE OF LANDMARK
P.K. NAIL 2'± SOUTH OF CENTERLINE
BEARINGS ARE REFERENCED TO
ASSUMED NORTH.

## LOCATION OF LANDMARK

CREW: WILLIAM C. JUNG  
PETER F. FOLLANSBEE  
DATE: 6/15/1998

Describe any record evidence, monument evidence, testimonial evidence or any other material evidence you considered and whether the monument was found or restored through acceptance of an obliterated evidence location.


As the P.K. nail was covered up by recent road work, we set a new P.K. nail at the corner.

Describe or show any material discrepancy between the location of the restored corner and that of the corner previously restored or reestablished.

**NONE KNOWN.**


RECORD OF DURABLE WITNESS MONUMENTS  
ASSUMED

NO	DESCRIPTION	BEARING	DISTANCE
1	EXISTING IRON PIPE FROM HURLBURT SURVEY	S 76°20'12"W	247.21 FT.
2	EXISTING PUNCH HOLE IN EAST END C.M.P.	N 24°05'04"W	35.71 FT.
3	EXISTING IRON PIPE ON TOP OF THE BANK	N 00°10'04"W	70.96 FT.
4	EXISTING IRON PIPE ON TOP OF THE BANK	N 24°50'02"E	78.65 FT.

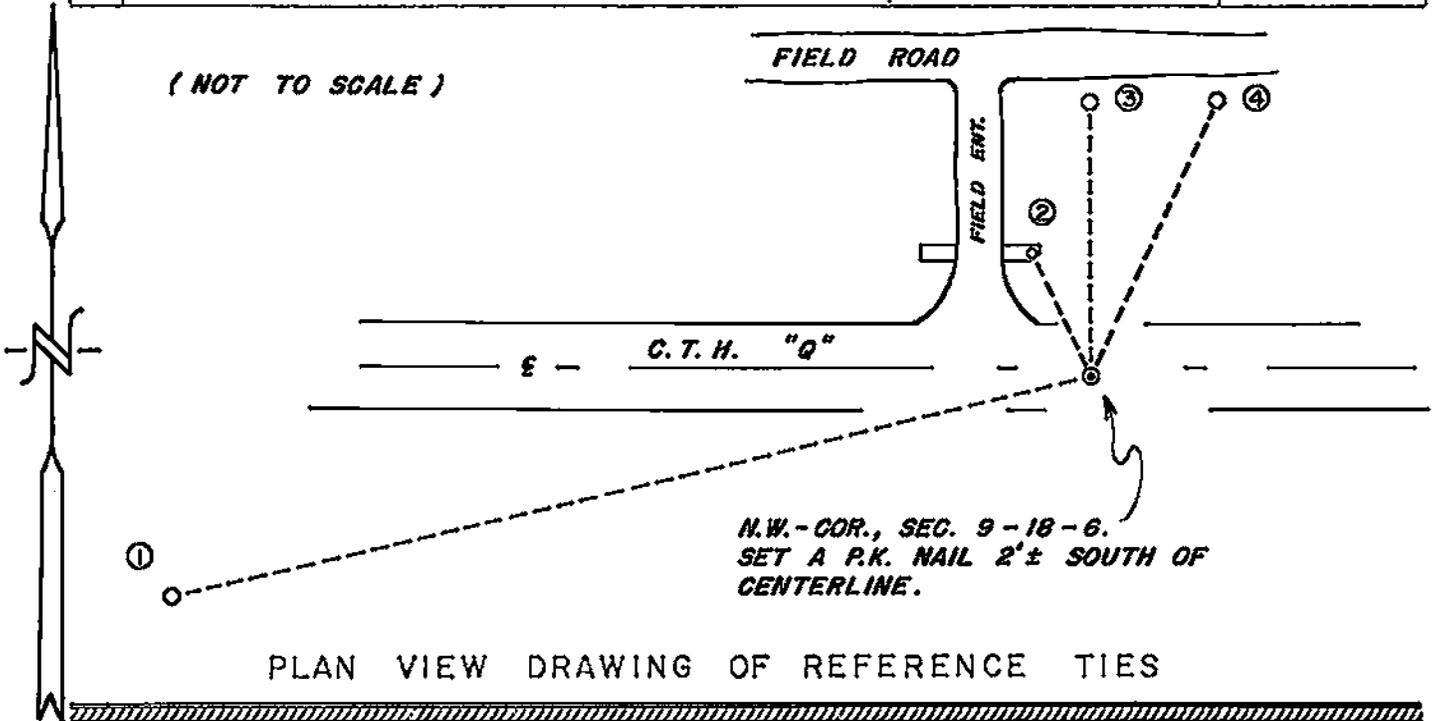


MAP SHOWING DISTANCE AND DIRECTION TO OTHER PUBLIC LAND SURVEY CORNERS USED FOR REESTABLISHING THE CORNER

(not to scale)

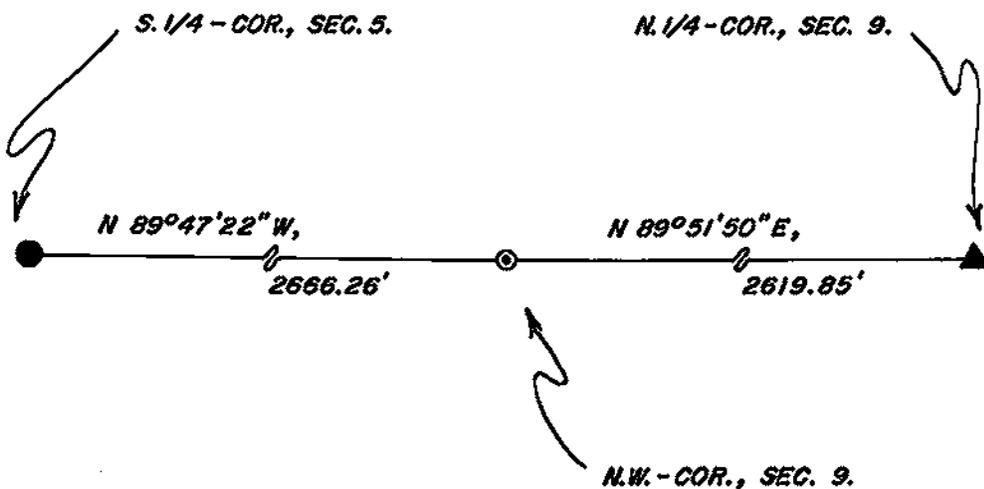

I, WILLIAM C. JUNG, COUNTY SURVEYOR  
HEREBY CERTIFY THAT THE CORNER LOCATION SHOWN ON THIS RECORD WAS DETERMINED BY ME OR UNDER MY DIRECTION AND CONTROL AND THAT THIS U. S. PUBLIC LAND SURVEY MONUMENT RECORD IS CORRECT AND COMPLETE TO THE BEST OF MY KNOWLEDGE AND BELIEF.

William C. Jung 4/16/99  
Signature Date

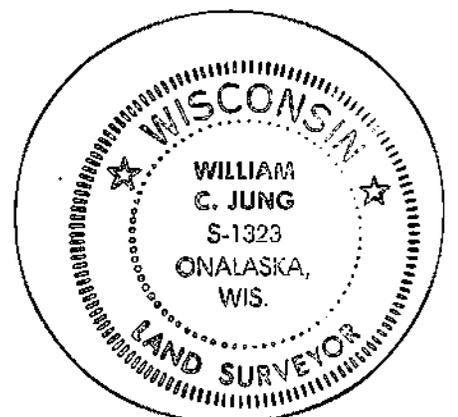


Seal

## U. S. PUBLIC LAND SURVEY MONUMENT RECORD

SECTION 9 T 18 N, R 6 W, TOWN OF FARMINGTON

LA CROSSE COUNTY

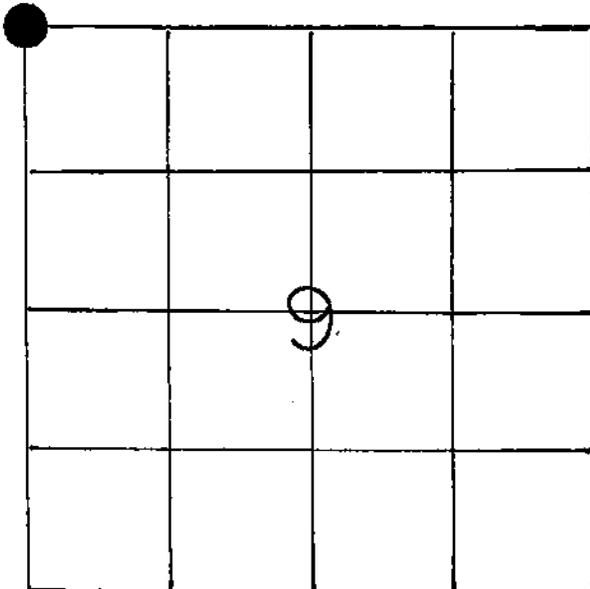

LOCATION OF LANDMARK

CREW: WILLIAM JUNG  
PERRY DAHL

5/22/87

Describe any record evidence, monument evidence, testimonial evidence or any other material evidence you considered and whether the monument was found or restored through acceptance of an obliterated evidence location.

I found a P.K. nail at the corner. Norm Hurlburt set this P.K. nail at a computed location for the section corner.

Describe or show any material discrepancy between the location of the restored corner and that of the corner previously restored or reestablished.

NONE KNOWN.

WISCONSIN COORDINATE SYSTEM

North

East

Theta Angle

Horiz. Order

Vert. Order


TYPE OF LANDMARK

P. K. NAIL

BEARINGS ARE REFERENCED TO  
ASSUMEDVOID

RECORD OF DURABLE WITNESS MONUMENTS

NO	DESCRIPTION	BEARING	DISTANCE
1	PUNCHED HOLE IN CULVERT	—————	35.73'
2	SET 1/4" IRON BAR	NORTH ±	70.95'
3	SET 1/4" IRON BAR BEHIND R/W POST	—————	78.70'
4	P.K. NAIL IN BIT. PAVEMENT	EAST ±	33.00'
5	P.K. NAIL IN BIT. PAVEMENT	EAST ±	98.00'

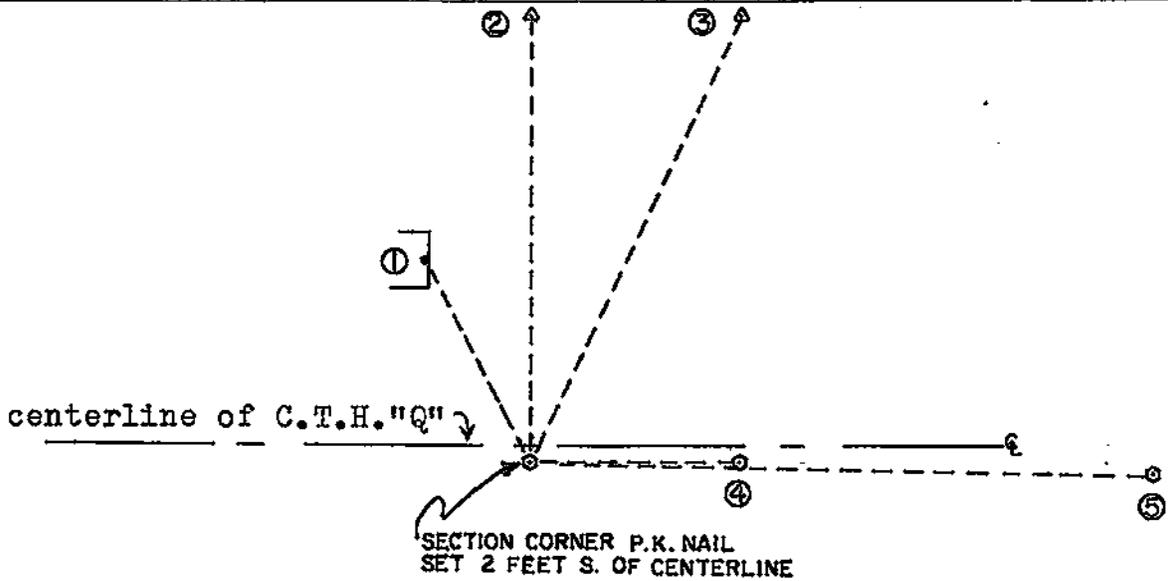


PLAN VIEW DRAWING OF REFERENCE TIES

MAP SHOWING DISTANCE AND DIRECTION TO OTHER PUBLIC LAND SURVEY CORNERS USED FOR REESTABLISHING THE CORNER


( Not to scale )

( Hurlburt measurements )

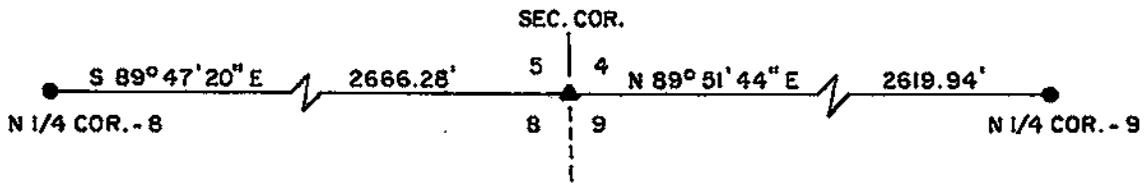

I, WILLIAM C. JUNG  
 HEREBY CERTIFY THAT THE CORNER LOCATION SHOWN ON THIS RECORD  
 WAS DETERMINED BY ME OR UNDER MY DIRECTION AND CONTROL AND  
 THAT THIS U. S. PUBLIC LAND SURVEY MONUMENT RECORD IS CORRECT  
 AND COMPLETE TO THE BEST OF MY KNOWLEDGE AND BELIEF.

*William C. Jung* Deputy County Surveyor, December 18, 1987  
 Signature Date

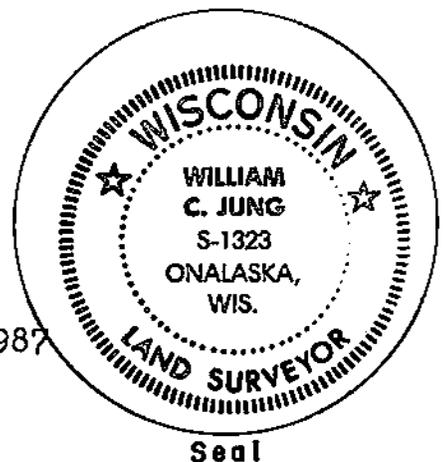

Seal