


U. S. PUBLIC LAND SURVEY MONUMENT RECORD

SECTION 8 T 18 N, R 6 W, TOWN OF FARMINGTON
LA CROSSE COUNTY

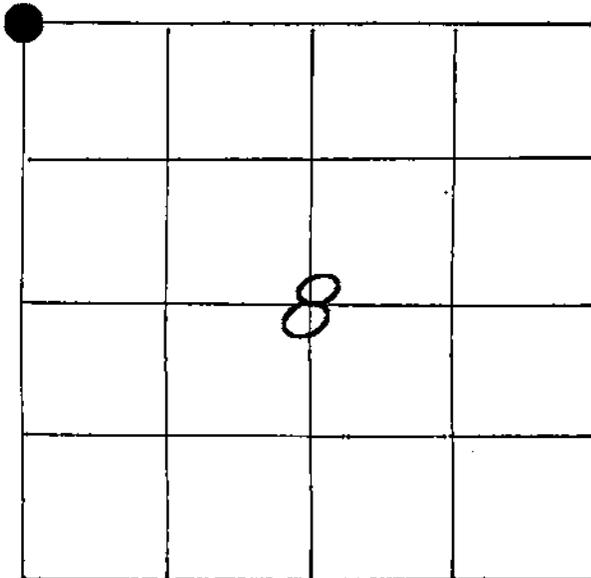

LOCATION OF LANDMARK

CREW: WILLIAM C. JUNG
PETER F. FOLLANSBEE
DATE: 6/15/1998

WISCONSIN COORDINATE SYSTEM

North

East

Theta Angle

Horiz. Order

Vert. Order

TYPE OF LANDMARK

1" x 6-1/2" STEEL SHAFT OVER EX. 2" I.P.

BEARINGS ARE REFERENCED TO

ASSUMED NORTH.

Describe any record evidence, monument evidence, testimonial evidence or any other material evidence you considered and whether the monument was found or restored through acceptance of an obliterated evidence location.

Due to recent road construction, we found the pipe covered. We set a 1"x6½" iron bar over the pipe at the road intersection.


Describe or show any material discrepancy between the location of the restored corner and that of the corner previously restored or reestablished.

NONE KNOWN.

RECORD OF DURABLE WITNESS MONUMENTS


ASSUMED

NO	DESCRIPTION	BEARING	DISTANCE
1	SET 7/8" x 16" IRON BAR (THREADED), 12" S EAST OF FENCE	S 26°55'20" W	147.80 FT.
2	SET NAIL IN SW-SIDE 18" WALNUT TREE (UNBLAZED)	N 08°33'05" W	83.66 FT.
3	EXISTING P.K. & TAB IN WEST SIDE WOOD R/W POST	N 00°09'18" W	49.80 FT.
4	SET NAIL IN ROOT ON N.W.-SIDE 14" ELM (UNBLAZED)	S 48°48'20" E	109.83 FT.

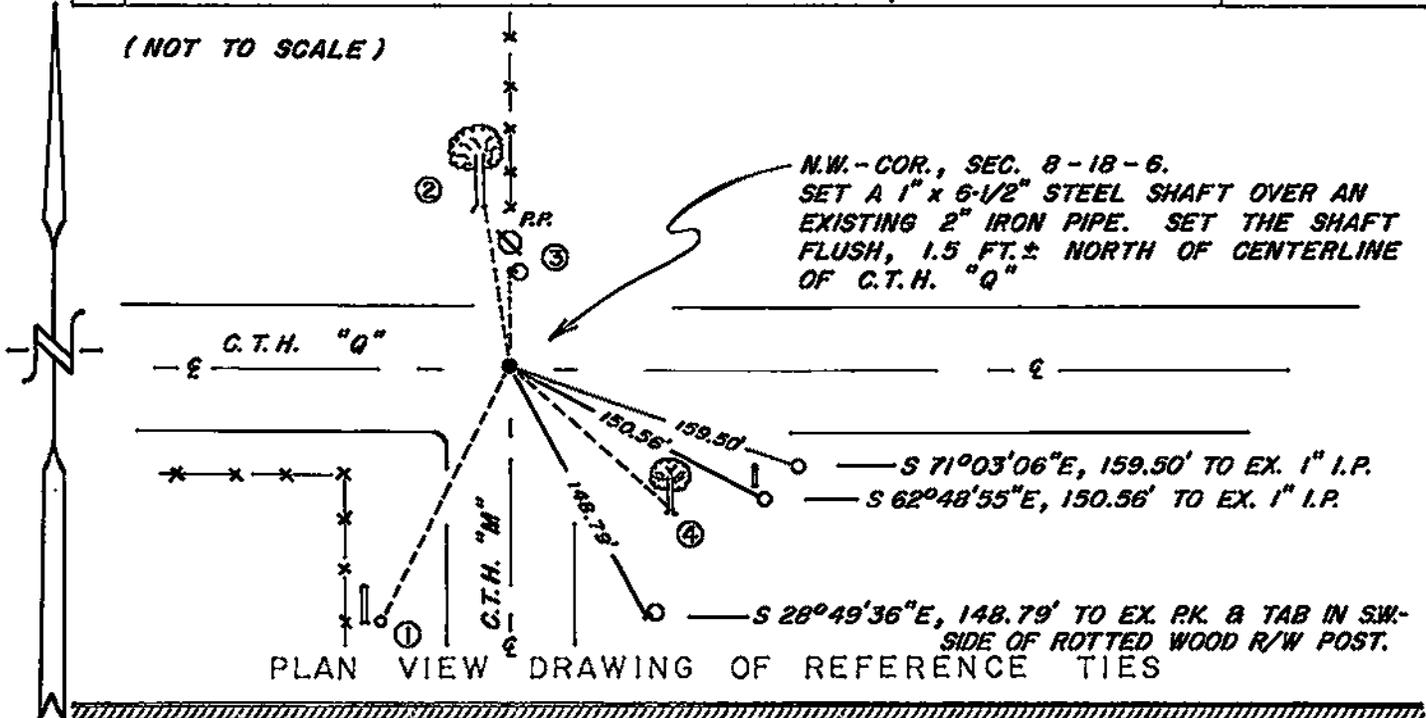


MAP SHOWING DISTANCE AND DIRECTION TO OTHER PUBLIC LAND SURVEY CORNERS USED FOR REESTABLISHING THE CORNER

(not to scale)

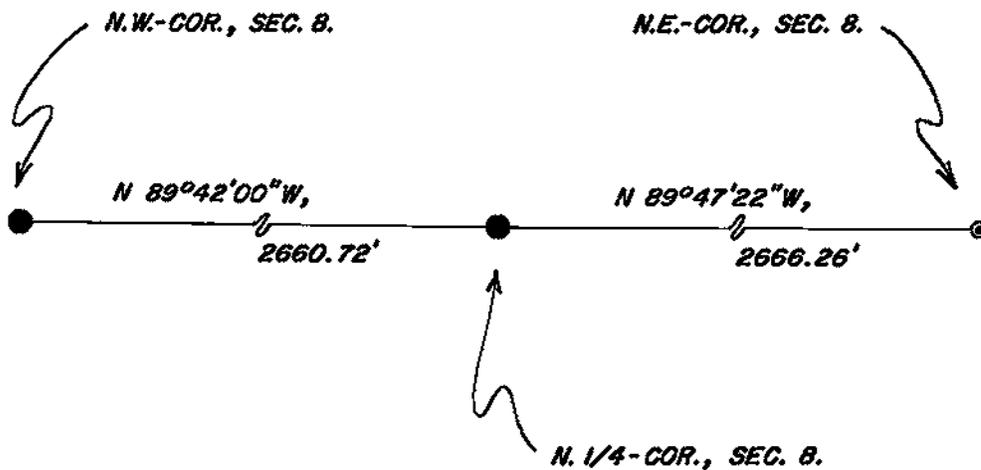

I, WILLIAM C. JUNG, COUNTY SURVEYOR
HEREBY CERTIFY THAT THE CORNER LOCATION SHOWN ON THIS RECORD WAS DETERMINED BY ME OR UNDER MY DIRECTION AND CONTROL AND THAT THIS U. S. PUBLIC LAND SURVEY MONUMENT RECORD IS CORRECT AND COMPLETE TO THE BEST OF MY KNOWLEDGE AND BELIEF.

William C. Jung 4/16/99
Signature Date

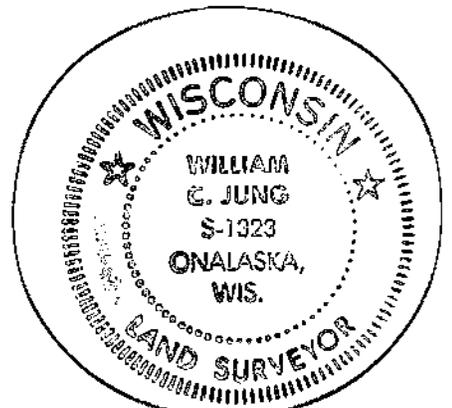


Seal

U. S. PUBLIC LAND SURVEY MONUMENT RECORD

SECTION 8 T 18 N, R 6 W, TOWN OF FARMINGTON

LA CROSSE COUNTY

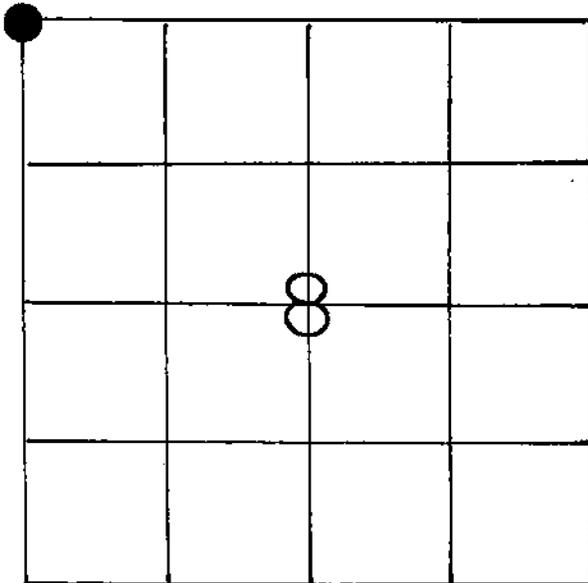

LOCATION OF LANDMARK

CREW: BILL JUNG
 PERRY DAHL
 DATE: 10-22-85

WISCONSIN COORDINATE SYSTEM
North
East
Theta Angle
Horiz. Order
Vert. Order
TYPE OF LANDMARK
2" IRON PIPE
BEARINGS ARE REFERENCED TO

Describe any record evidence, monument evidence, testimonial evidence or any other material evidence you considered and whether the monument was found or restored through acceptance of an obliterated evidence location.

This point has been used as the corner in previous surveys by Berg and Pederson. I accepted the position of this pipe as the best available evidence of the original government corner.
 (Berg set the pipe.)


Describe or show any material discrepancy between the location of the restored corner and that of the corner previously restored or reestablished.

None known.

VOID

RECORD OF DURABLE WITNESS MONUMENTS

NO	DESCRIPTION	BEARING	DISTANCE
1	P.K. NAIL IN RIGHT-OF-WAY POST	NORTH \pm	49.8'
2	P.K. NAIL IN RIGHT-OF-WAY POST	-----	148.1'
3	P.K. NAIL IN RIGHT-OF-WAY POST	-----	149'
4			

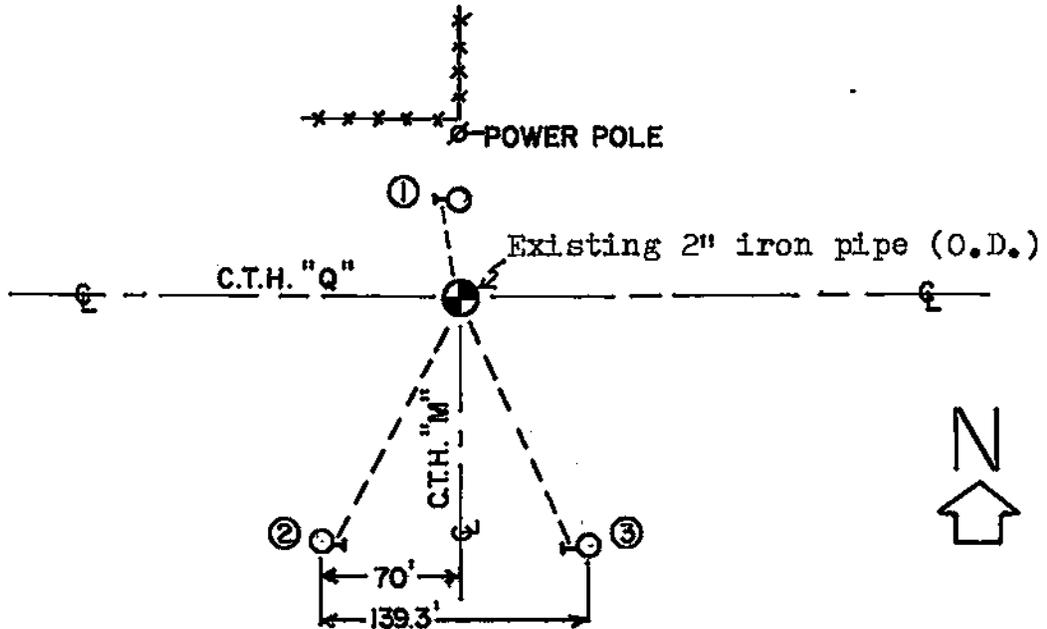

PLAN VIEW DRAWING OF REFERENCE TIES

MAP SHOWING DISTANCE AND DIRECTION TO OTHER PUBLIC LAND SURVEY CORNERS USED FOR REESTABLISHING THE CORNER

None measured by me at this time. See Berg's surveys of September, 1981, in Section 7 and his survey of October, 1983, in Section 5.

I, William C. Jung, Deputy County Surveyor,
 HEREBY CERTIFY THAT THE CORNER LOCATION SHOWN ON THIS RECORD
 WAS DETERMINED BY ME OR UNDER MY DIRECTION AND CONTROL AND
 THAT THIS U. S. PUBLIC LAND SURVEY MONUMENT RECORD IS CORRECT
 AND COMPLETE TO THE BEST OF MY KNOWLEDGE AND BELIEF.

William C. Jung
 Signature

2/7/86
 Date



Seal