


21806060020

U. S. PUBLIC LAND SURVEY MONUMENT RECORD

SECTION 6 T 18 N, R 6 W, TOWN OF FARMINGTON
 LA CROSSE COUNTY

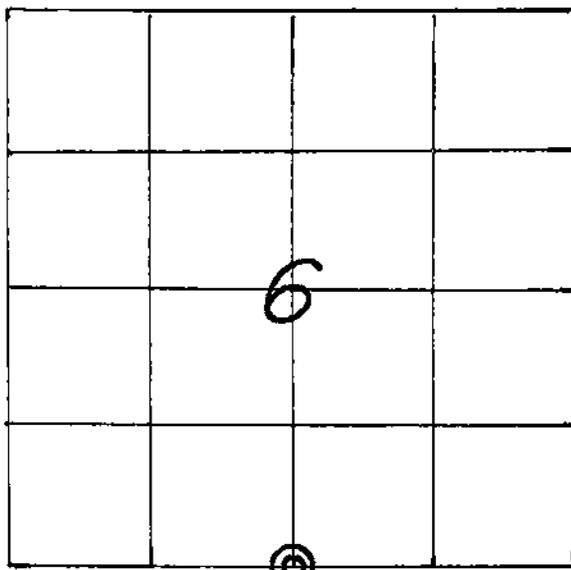

LOCATION OF LANDMARK

CREW: **WILLIAM C. JUNG**
PETER F. FOLLANSBEE
 DATE: **9/28/2001**

Dates: 1/12/96 and 10/16/01

Describe any record evidence, monument evidence, testimonial evidence or any other material evidence you considered and whether the monument was found or restored through acceptance of an obliterated evidence location.

I found an iron pipe at the corner. The pipe was buried, down 13 inches. This pipe had been used in previous survey work. I accepted its location as the best available evidence of the original government corner position. I set a spike over the top of the pipe.


Describe or show any material discrepancy between the location of the restored corner and that of the corner previously restored or reestablished.

NONE KNOWN.

WISCONSIN COORDINATE SYSTEM	
North	751,957.716 '83(91)
East	1,668,113.036
Theta Angle	
Horiz. Order	
Vert. Order	
TYPE OF LANDMARK	
12" SPIKE WITH WASHERS IN PAVEMENT.	
BEARINGS ARE REFERENCED TO	
Grid North	


RECORD OF DURABLE WITNESS MONUMENTS

NO	DESCRIPTION	BEARING	DISTANCE
1	SET 18" ROUNDHEAD BOLT AT TOP OF BACKSLOPE	NORTH ±	23.21 FT.
2	SET 10" SPIKE IN CENTERLINE OF GRAVEL DRIVEWAY	S.'EASTERLY ±	SLOPE = 81.80'
3	SET A 3/4" x 30" IRON BAR 18" S. N. OF WOOD POST	S.'EASTERLY ±	36.70 FT.
4	SET NAIL IN W.-SIDE OF AN 11-1/2" OAK	S.'WESTERLY ±	SLOPE = 60.77'

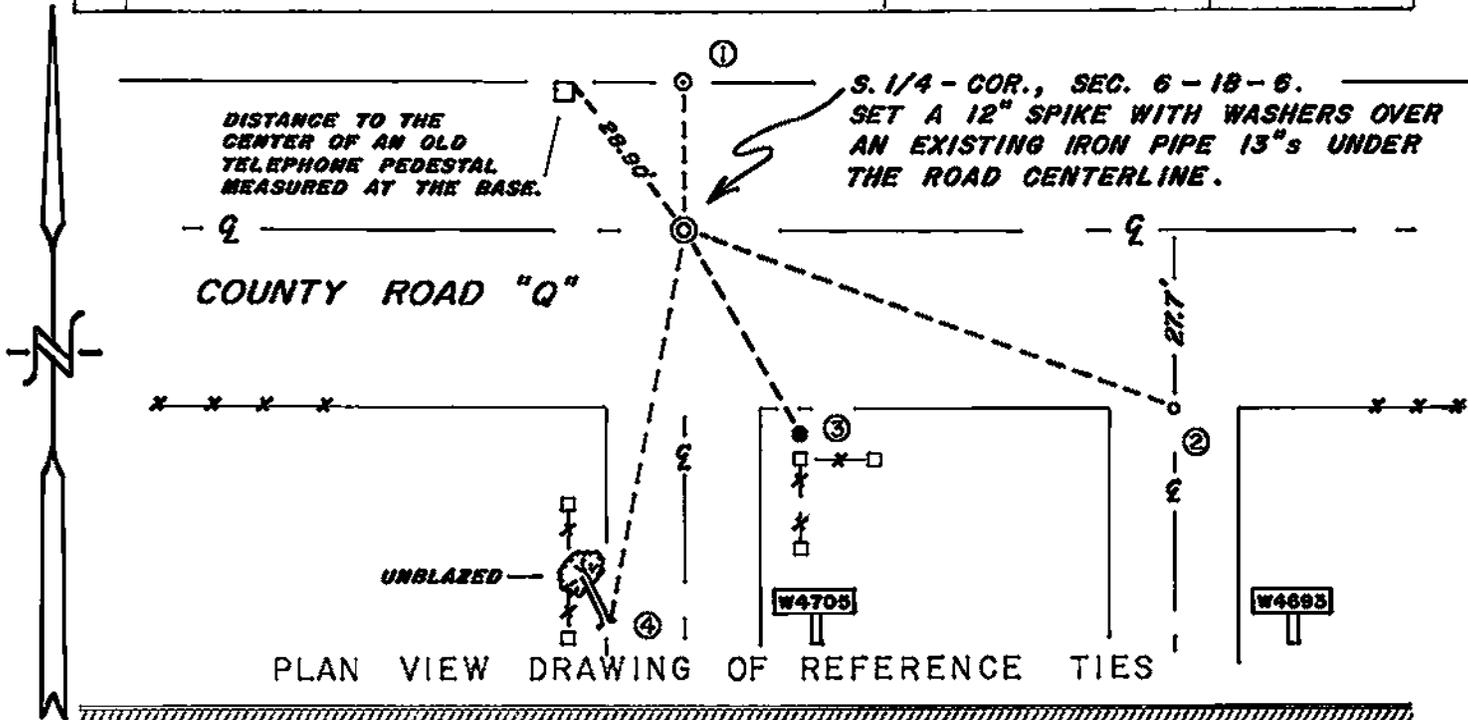

MAP SHOWING DISTANCE AND DIRECTION TO OTHER PUBLIC LAND SURVEY CORNERS USED FOR REESTABLISHING THE CORNER


(not to scale)

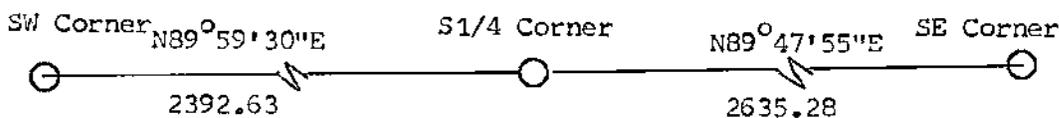

(grid distances)

I, WILLIAM C. JUNG, COUNTY SURVEYOR
 HEREBY CERTIFY THAT THE CORNER LOCATION SHOWN ON THIS RECORD
 WAS DETERMINED BY ME OR UNDER MY DIRECTION AND CONTROL AND
 THAT THIS U. S. PUBLIC LAND SURVEY MONUMENT RECORD IS CORRECT
 AND COMPLETE TO THE BEST OF MY KNOWLEDGE AND BELIEF.

William C. Jung 3/26/02
 Signature Date

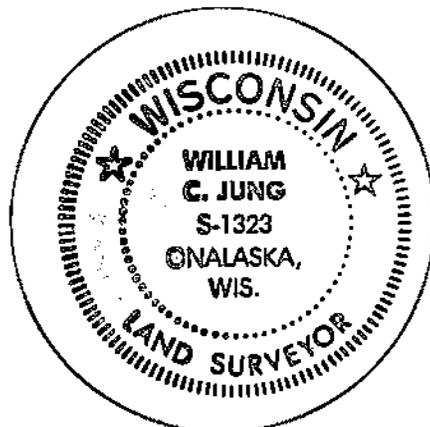

Seal