


21806062000

U. S. PUBLIC LAND SURVEY MONUMENT RECORD

SECTION 5 T 18 N, R 6 W, TOWN OF FARMINGTON
 LA CROSSE COUNTY

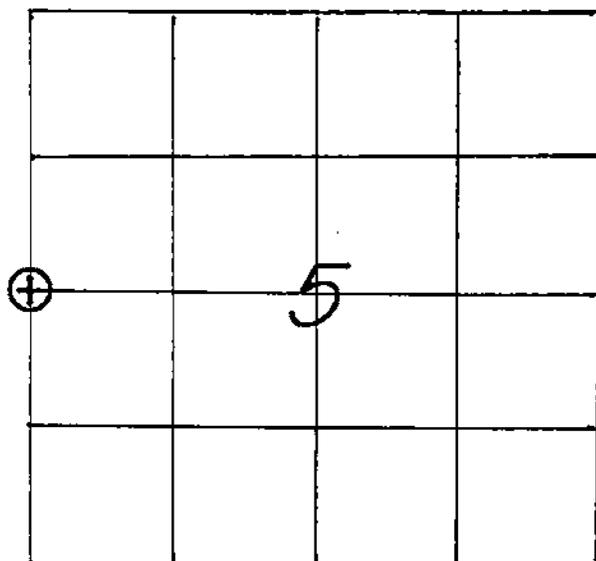

LOCATION OF LANDMARK

CREW: *WILLIAM C. JUNG*
PETER F. FOLLANSBEE
 DATE: *4/16/2002*

WISCONSIN COORDINATE SYSTEM	
North	<i>754,597.232</i>
East	<i>1,670,803.258</i>
Theta Angle	
Horiz. Order	
Vert. Order	
DATUM:	<i>1983 ('91)</i>
TYPE OF LANDMARK	
<i>3/4" x 30" IRON BAR WITH ALUMINUM CAP.</i>	
BEARINGS ARE REFERENCED TO	
Grid North	

Describe any record evidence, monument evidence, testimonial evidence or any other material evidence you considered and whether the monument was found or restored through acceptance of an obliterated evidence location.

I set this corner by projecting a line through the W1/4 corner and C1/4 of Section 6 and intersecting this line with the West line of Section 5. The line to the North is almost two chains short of the original government notes suggesting an error in the original tally. I set an iron bar and cap at the corner.

Describe or show any material discrepancy between the location of the restored corner and that of the corner previously restored or reestablished.

NONE KNOWN.

