


U. S. PUBLIC LAND SURVEY MONUMENT RECORD

SECTION 7 T 18 N, R 6 W, TOWN OF FARMINGTON
 LA CROSSE COUNTY

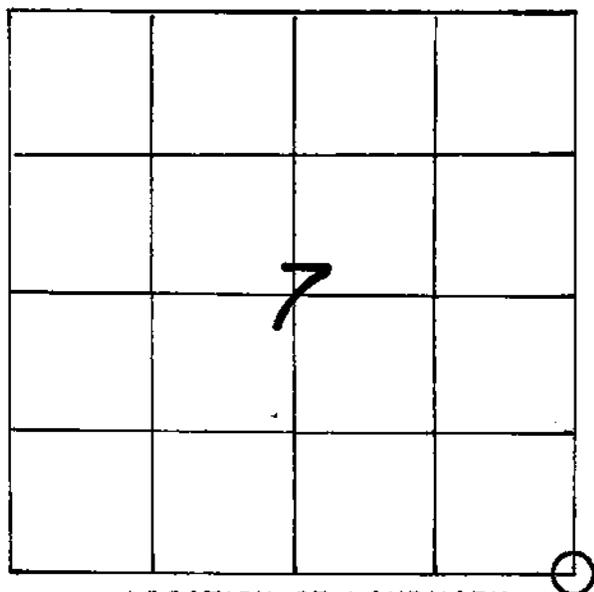

LOCATION OF LANDMARK

WISCONSIN COORDINATE SYSTEM
North
East
Theta Angle
Horiz. Order
Vert. Order
TYPE OF LANDMARK
Exist. 1-3/4" Iron Pipe.
BEARINGS ARE REFERENCED TO

Crew: WILLIAM C. JUNG
 PETER F. FOLLANSBEE
 Date: 3/20/1996

Describe any record evidence, monument evidence, testimonial evidence or any other material evidence you considered and whether the monument was found or restored through acceptance of an obliterated evidence location.

I found an existing pipe at the occupied corner. This pipe has been used in previous survey work. I accepted this location as the best available evidence of the original government corner position.

Describe or show any material discrepancy between the location of the restored corner and that of the corner previously restored or reestablished.

NONE KNOWN.

RECORD OF DURABLE WITNESS MONUMENTS

NO	DESCRIPTION	MAGNETIC	
		BEARING	DISTANCE
1	Set P.K. Nail in W.-side 6½" Cedar	North+	7.41 Ft.
2	Set P.K. Nail in W.-side 14" White Oak	N 14°E	26.67 Ft.
3	Set P.K. Nail in NW-side 15" Black Oak	N 51°E	26.49 Ft.
4	Set P.K. Nail in N.-side 9" White Oak	S 87°E	Sl.=18.82'


(Note: the 4 B.T.'s are double blazed.)

SE-Cor., Sec. 7-18-6.
Existing 1-3/4" Iron Pipe,
up 4"s, under a N.-S. fence
and north of a large Oak.

Large White Oak,
circumference is 9.6'.
Nailed a sign to it.

LARGE STUMP, 2' DIAM'R±.
WHITE OAK WITH A POSSIBLE
SCAR ON THE S.W. SIDE.
N 15°E, 56.3' FROM CORNER.

(WOODS)

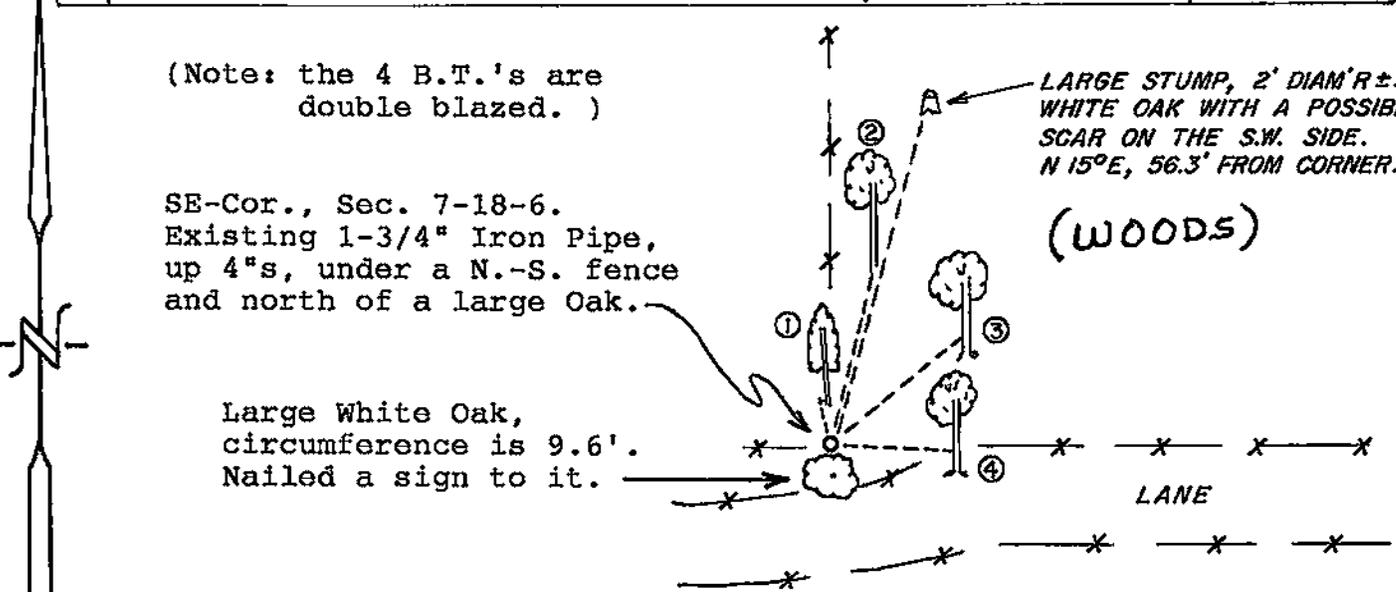

(Not to scale)


PLAN VIEW DRAWING OF REFERENCE TIES

MAP SHOWING DISTANCE AND DIRECTION TO OTHER PUBLIC LAND SURVEY CORNERS USED FOR REESTABLISHING THE CORNER

No section measurements were made by me at this time. This position was confirmed by previous survey work.

I, William C. Jung, County Surveyor
HEREBY CERTIFY THAT THE CORNER LOCATION SHOWN ON THIS RECORD
WAS DETERMINED BY ME OR UNDER MY DIRECTION AND CONTROL AND
THAT THIS U. S. PUBLIC LAND SURVEY MONUMENT RECORD IS CORRECT
AND COMPLETE TO THE BEST OF MY KNOWLEDGE AND BELIEF.

William C. Jung 12/2/96
Signature Date

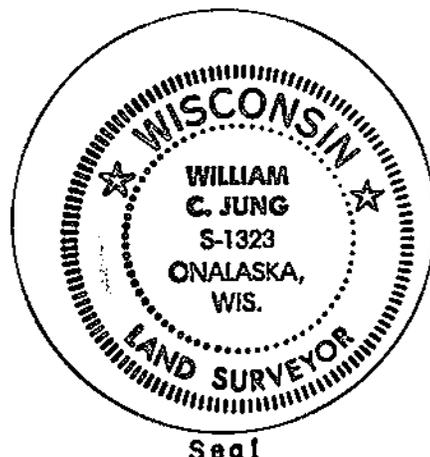

Seal