


U. S. PUBLIC LAND SURVEY MONUMENT RECORD

SECTION 9 T 18 N, R 6 W, TOWN OF FARMINGTON

LA CROSSE COUNTY

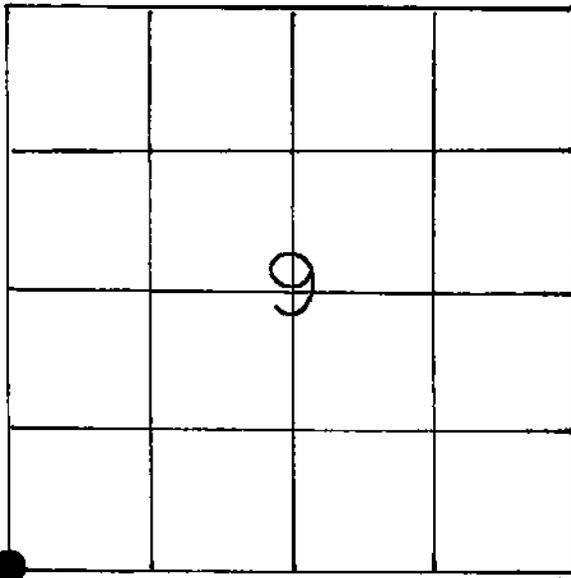

LOCATION OF LANDMARK

CREW: BILL JUNG
 PERRY DAHL
 DATE: 10-22-85

WISCONSIN COORDINATE SYSTEM

North

East

Theta Angle

Horiz. Order

Vert. Order

TYPE OF LANDMARK

BERNTSEN

BEARINGS ARE REFERENCED TO

Revision:

Crew: Jung
 Date: 4-17-91

* See below

Describe any record evidence, monument evidence, testimonial evidence or any other material evidence you considered and whether the monument was found or restored through acceptance of an obliterated evidence location.

In October of 1985 Norm Hurlburt surveyed out Section 9 and determined the computed location of this corner. I set the corner at Norm's computed location, the corner being a Berntsen marker now. In my opinion this computed location fits the field evidence very well.

Describe or show any material discrepancy between the location of the restored corner and that of the corner previously restored or reestablished.

None known.


* 4-17-91

In 1990 Norm Hurlburt found that this corner had been disturbed. He set it back in its former position. A surveyor from Strand and Associates traversed to it at a later date and found that it checked out with its 1985 position. The old line had been grubbed out; the fence moved North. I found the Berntsen, up 2", and 3.9 feet South of the new fence. I set a sign and post to the East. The center of this post is 1.02' East of the corner. The center of a new steel fence post to the Northwest is 6.08' from the Berntsen.

wey

RECORD OF DURABLE WITNESS MONUMENTS

NO	DESCRIPTION	BEARING	DISTANCE
1	1½" IRON PIPE	EAST ±	32.95'
2	1½" IRON PIPE	WEST ±	32.98'
3			
4			

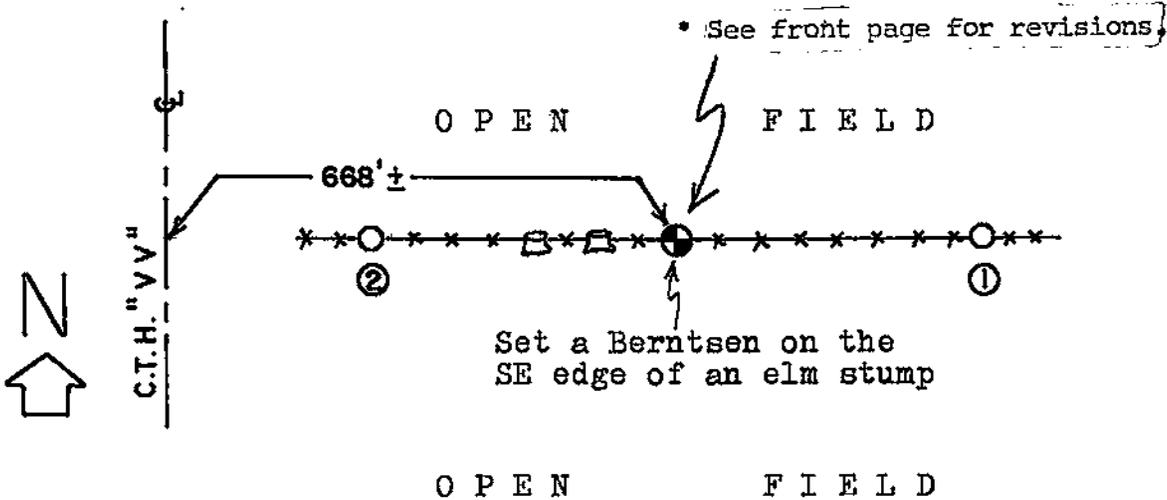

PLAN VIEW DRAWING OF REFERENCE TIES

MAP SHOWING DISTANCE AND DIRECTION TO OTHER PUBLIC LAND SURVEY CORNERS USED FOR REESTABLISHING THE CORNER

None measured by me at this time. See Hurlburt's map, dated 11/13/85.

I, William C. Jung, Deputy County Surveyor,
 HEREBY CERTIFY THAT THE CORNER LOCATION SHOWN ON THIS RECORD
 WAS DETERMINED BY ME OR UNDER MY DIRECTION AND CONTROL AND
 THAT THIS U. S. PUBLIC LAND SURVEY MONUMENT RECORD IS CORRECT
 AND COMPLETE TO THE BEST OF MY KNOWLEDGE AND BELIEF.

William C. Jung
 Signature

2/7/86
 Date

Revised: 4/17/91

wcj

