


21806090000

U. S. PUBLIC LAND SURVEY MONUMENT RECORD

SECTION 9 T 18 N, R 6 W, TOWN OF FARMINGTON

LA CROSSE COUNTY

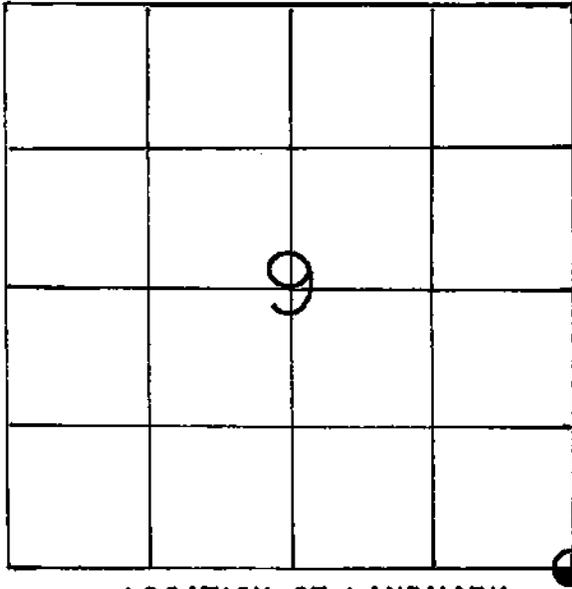

LOCATION OF LANDMARK

WISCONSIN COORDINATE SYSTEM
North
East
Theta Angle
Horiz. Order
Vert. Order
TYPE OF LANDMARK
BERNTSEN
BEARINGS ARE REFERENCED TO

CREW: BILL JUNG  
 PERRY DAHL  
 DATE: 10-22-85

Crew: Bill Jung  
 Pete Follansbee  
 Dates: 3/8/00 and 7/20/00

Describe any record evidence, monument evidence, testimonial evidence or any other material evidence you considered and whether the monument was found or restored through acceptance of an obliterated evidence location.

I accepted the occupied fence corner as the best available evidence of the original government corner and monumented it with a Berntsen marker. Norm Hurlburt and I both agreed that this fence corner should be accepted.

2000-The monument had gone off plumb to the North. We plumbed it back up. The fence corner post in now is probably not the same as the one in 1985.


Describe or show any material discrepancy between the location of the restored corner and that of the corner previously restored or reestablished.

None known.

RECORD OF DURABLE WITNESS MONUMENTS  
MAGNETIC

NO	DESCRIPTION	BEARING	DISTANCE
1	P.K. NAIL IN DOUBLE-BLAZED 13" ASPEN	N22°W	31.36' (SLOPE)
2	P.K. NAIL IN DOUBLE-BLAZED 23" OAK TREE	N72°W	64.7'
3	P.K. NAIL IN DOUBLE-BLAZED 22" WHITE OAK	S34°W	SLOPE 43.8
4	P.K. NAIL IN DOUBLE-BLAZED 17" WHITE OAK	S6°E	18.28'

(Each distance is to a P.K. nail in a hack on the side of the tree.)

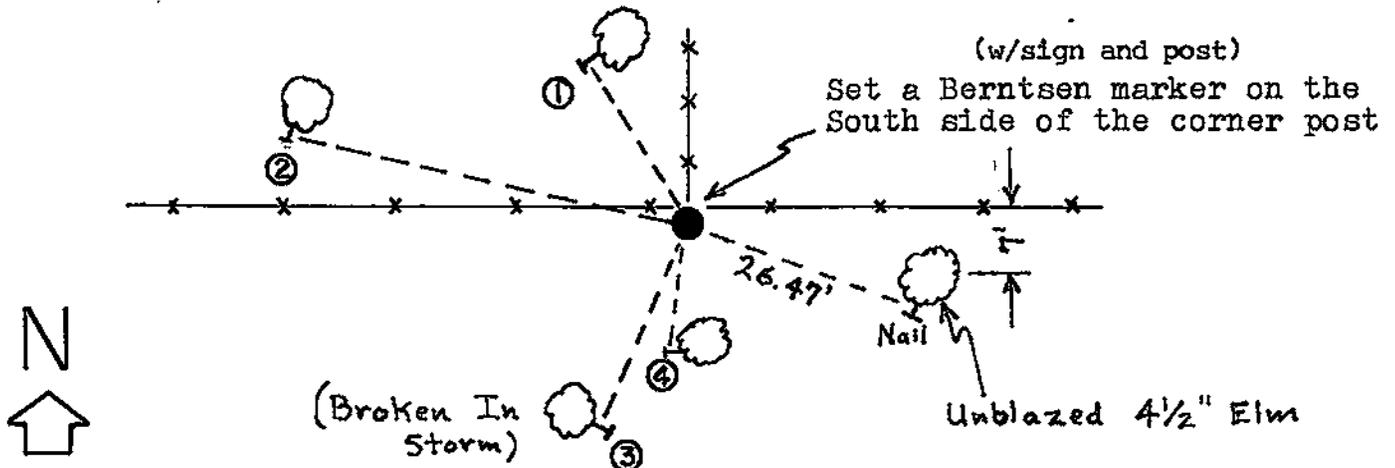

PLAN VIEW DRAWING OF REFERENCE TIES

MAP SHOWING DISTANCE AND DIRECTION TO OTHER PUBLIC LAND SURVEY CORNERS USED FOR REESTABLISHING THE CORNER

None measured by me at this time. See Hurlburt's map, dated 11/13/85.

2000- I checked Hurlburt's distance along the West line of Section 10 within 0.08 ft. See my tie sheet for the S1/4 Corner of Section 10 for the data on the South line of Section 10.

I, William C. Jung, ~~Deputy~~ County Surveyor,  
HEREBY CERTIFY THAT THE CORNER LOCATION SHOWN ON THIS RECORD WAS DETERMINED BY ME OR UNDER MY DIRECTION AND CONTROL AND THAT THIS U. S. PUBLIC LAND SURVEY MONUMENT RECORD IS CORRECT AND COMPLETE TO THE BEST OF MY KNOWLEDGE AND BELIEF.

William C. Jung  
Signature

2/7/86  
Date

Revised: 12/28/00 *WJG*

