


21806100000

U. S. PUBLIC LAND SURVEY MONUMENT RECORD

SECTION 11 T 18 N, R 6 W, TOWN OF FARMINGTON
LA CROSSE COUNTY

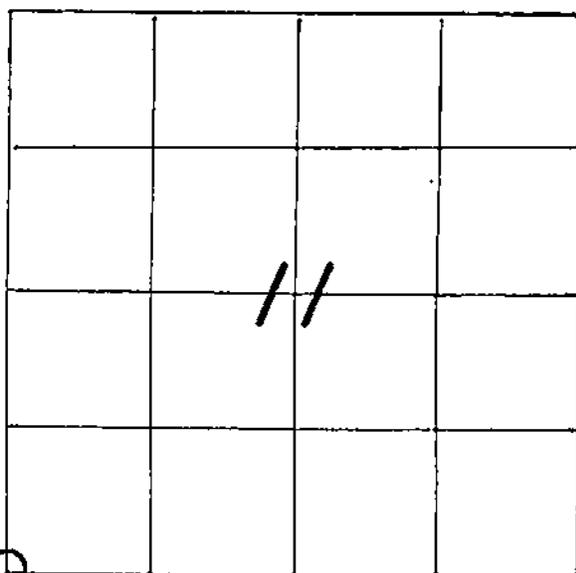

LOCATION OF LANDMARK

CREW: WILLIAM C. JUNG
PETER F. FOLLANSBEE
DATE: 3/16/2000

WISCONSIN COORDINATE SYSTEM

North 746,310.174

East 1,686,545.549

Theta Angle

Horiz. Order

Vert. Order

DATUM: 83('91)

TYPE OF LANDMARK
2" x 30" IRON PIPE. (I.D.)

BEARINGS ARE REFERENCED TO

GRID NORTH AS PER SECTION DATA.

Describe any record evidence, monument evidence, testimonial evidence or any other material evidence you considered and whether the monument was found or restored through acceptance of an obliterated evidence location.

We found a very old fence post where the wire had been tied off North-South in several places. It appeared to be the old occupied corner. After surveying out the rest of Sections 10 and 11, I found that this old tie post fit the existing field evidence very well. Therefore I accepted this location as the best available evidence of the original government corner position and monumented it with an iron pipe.

Describe or show any material discrepancy between the location of the restored corner and that of the corner previously restored or reestablished.

None known.

