


21806100020

U. S. PUBLIC LAND SURVEY MONUMENT RECORD

SECTION 10 T 18 N, R 6 W, TOWN OF FARMINGTON
 LA CROSSE COUNTY

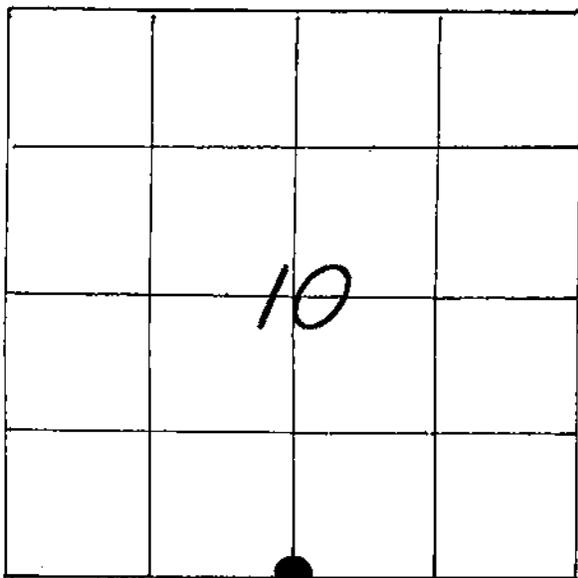

LOCATION OF LANDMARK

CREW: *WILLIAM C. JUNG*
PETER F. FOLLANSBEE
 DATE: *3/17/2000*

WISCONSIN COORDINATE SYSTEM

North *746,368.403*East *1,683,942.282*

Theta Angle

Horiz. Order

Vert. Order

DATUM: *83('91)*

TYPE OF LANDMARK

3/4" x 30" IRON BAR.

BEARINGS ARE REFERENCED TO

GRID NORTH AS PER SECTION DATA.

Describe any record evidence, monument evidence, testimonial evidence or any other material evidence you considered and whether the monument was found or restored through acceptance of an obliterated evidence location.


I set the corner by single proportionate measurement, equidistant and on line between the section corners. I set an iron bar at the corner.

Describe or show any material discrepancy between the location of the restored corner and that of the corner previously restored or reestablished.

None known.

RECORD OF DURABLE WITNESS MONUMENTS


NO	DESCRIPTION	BEARING	DISTANCE
1	SET A 3/4" x 30" IRON BAR 1' WEST OF PAVEMENT	N. WESTERLY ±	29.96 FT.
2	SET A 3/4" x 30" IRON BAR 1' EAST OF PAVEMENT	N. EASTERLY ±	30.00 FT.
3	SET A 3/4" x 30" IRON BAR 1' EAST OF PAVEMENT	S. EASTERLY ±	30.01 FT.
4	SET A 3/4" x 30" IRON BAR 1' WEST OF PAVEMENT	S. WESTERLY ±	30.03 FT.

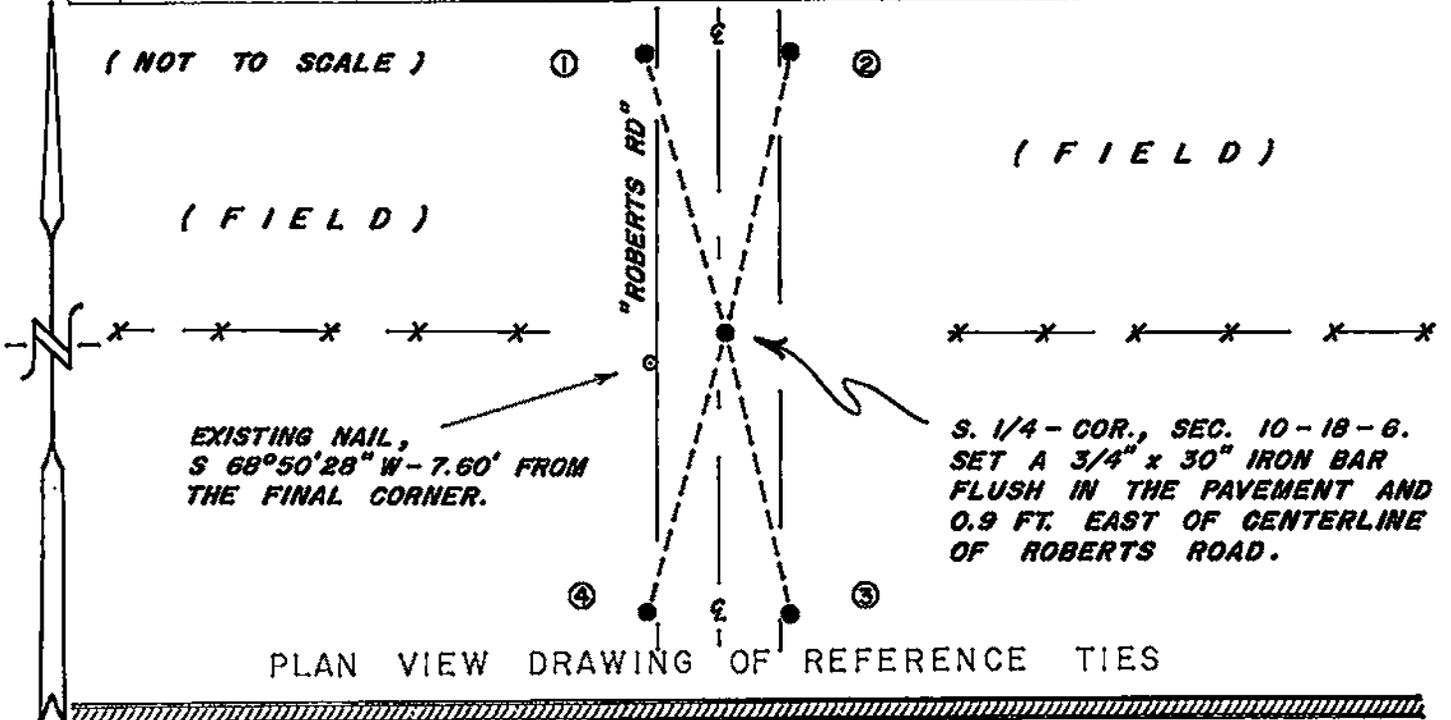

MAP SHOWING DISTANCE AND DIRECTION TO OTHER PUBLIC LAND SURVEY CORNERS USED FOR REESTABLISHING THE CORNER


(GRID BEARINGS & DISTANCES)

(not to scale)

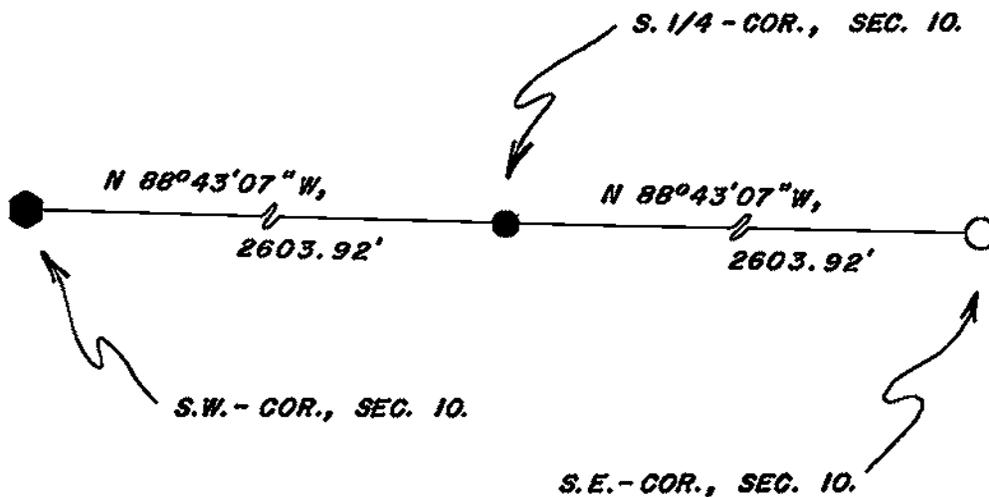

I, WILLIAM C. JUNG, COUNTY SURVEYOR
HEREBY CERTIFY THAT THE CORNER LOCATION SHOWN ON THIS RECORD
WAS DETERMINED BY ME OR UNDER MY DIRECTION AND CONTROL AND
THAT THIS U. S. PUBLIC LAND SURVEY MONUMENT RECORD IS CORRECT
AND COMPLETE TO THE BEST OF MY KNOWLEDGE AND BELIEF.

William C. Jung 5/11/00
Signature Date

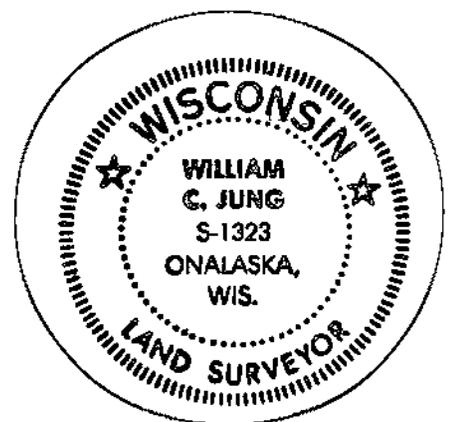

Seal