


21806102000

U. S. PUBLIC LAND SURVEY MONUMENT RECORD

SECTION 11 T 18 N, R 6 W, TOWN OF FARMINGTON

LA CROSSE COUNTY

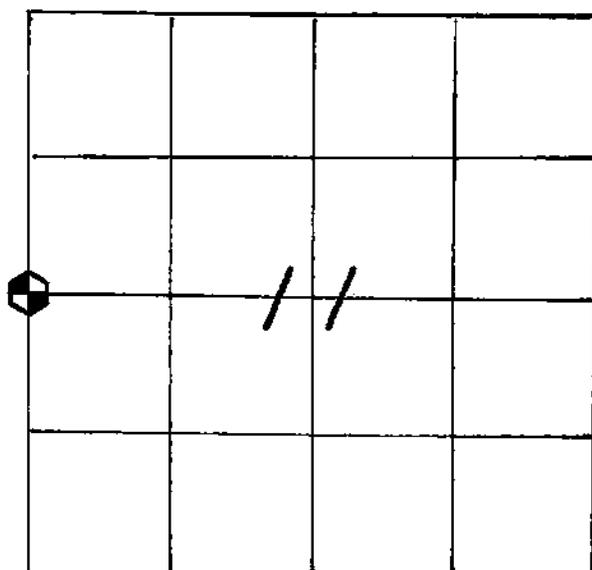

LOCATION OF LANDMARK

Crew: WILLIAM C. JUNG
 PETER F. FOLLANSBEE
 Date: 4/16/1997

WISCONSIN COORDINATE SYSTEM

North

East

Theta Angle

Horiz. Order

Vert. Order

TYPE OF LANDMARK

Brass cap Lunde marker.

BEARINGS ARE REFERENCED TO

Describe any record evidence, monument evidence, testimonial evidence or any other material evidence you considered and whether the monument was found or restored through acceptance of an obliterated evidence location.


Norm Hurlburt set an iron pipe at the old fence intersection. Norm and I agree that the 34" white oak to the Southwest is in all probability an original bearing tree. The fence corner fits the tree. I replaced Norm's pipe with a brass capped Lunde marker.

Describe or show any material discrepancy between the location of the restored corner and that of the corner previously restored or reestablished.

None Known.

**RECORD OF DURABLE WITNESS MONUMENTS
MAGNETIC**

NO	DESCRIPTION	BEARING	DISTANCE
1	Set nail in W.-side 34" W. Oak	S 19°W	37.68 Ft.
2	Set nail in SE-side 7½" Hickory	S 51°W	26.26 Ft.
3	Set nail in N.-side 12" Hickory	S 64°W	10.00 Ft.
4	Set nail in W.-side 28" W. Oak	N 25°E	sl.=43.51'

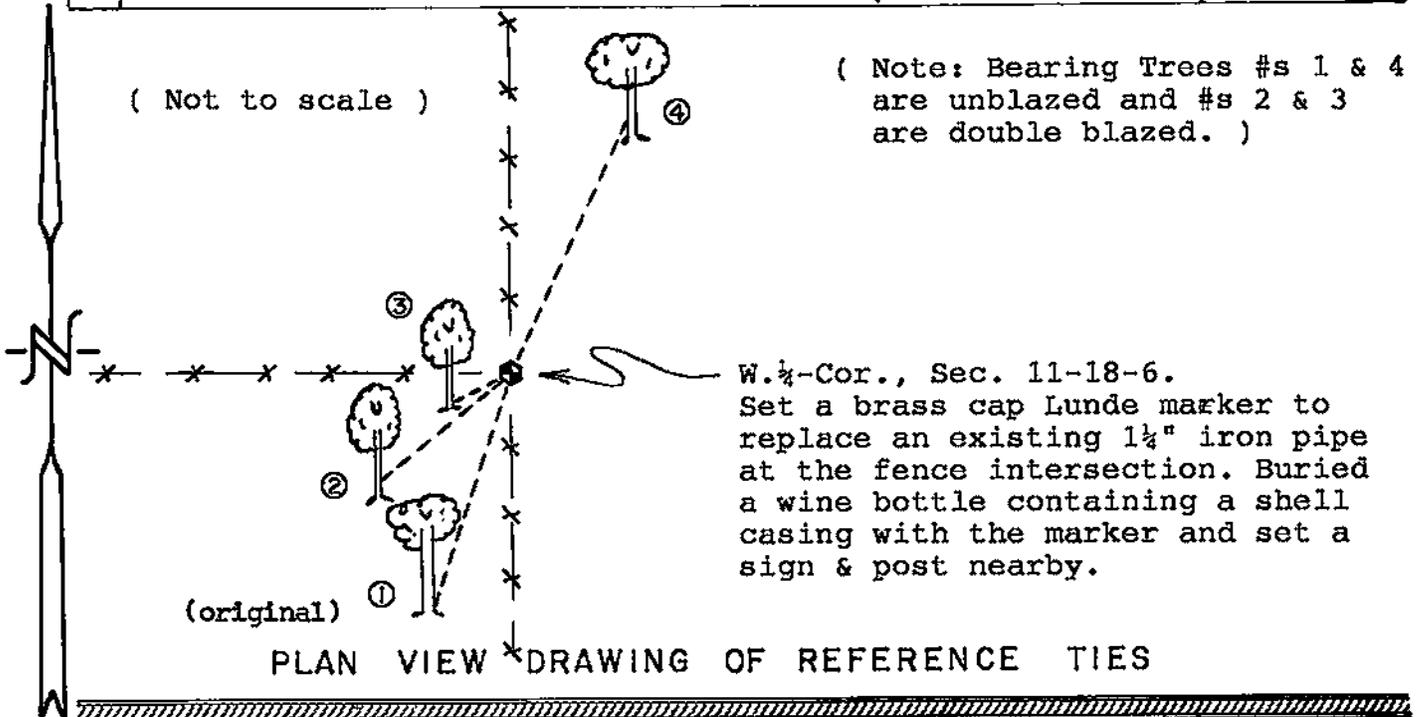


MAP SHOWING DISTANCE AND DIRECTION TO OTHER PUBLIC LAND SURVEY CORNERS USED FOR REESTABLISHING THE CORNER

No section measurements were made by me at this time. Norm Hulburt confirmed the location of this corner with his section measurements.

I, William C. Jung, County Surveyor
HEREBY CERTIFY THAT THE CORNER LOCATION SHOWN ON THIS RECORD WAS DETERMINED BY ME OR UNDER MY DIRECTION AND CONTROL AND THAT THIS U. S. PUBLIC LAND SURVEY MONUMENT RECORD IS CORRECT AND COMPLETE TO THE BEST OF MY KNOWLEDGE AND BELIEF.

William C. Jung
Signature

1/14/98
Date

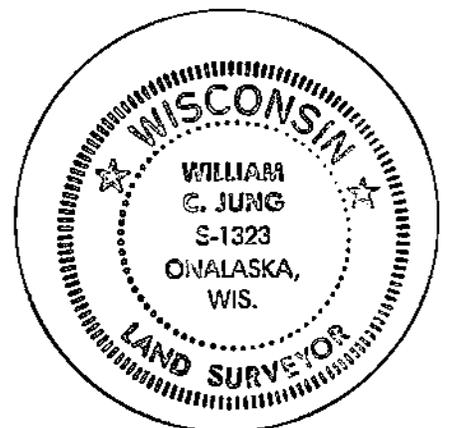

Seal