


21806110020

U. S. PUBLIC LAND SURVEY MONUMENT RECORD

SECTION 11 T 18 N, R 6 W, TOWN OF FARMINGTON
LA CROSSE COUNTY

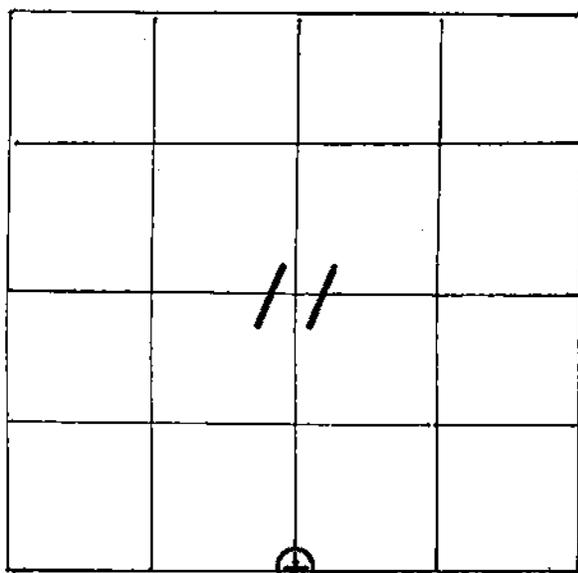

LOCATION OF LANDMARK

CREW: **WILLIAM C. JUNG**
PETER F. FOLLANSBEE
DATE: **3/16/2000**

WISCONSIN COORDINATE SYSTEM	
North	746,321.960
East	1,689,179.346
Theta Angle	
Horiz. Order	
Vert. Order	
DATUM:	83('91)
TYPE OF LANDMARK	
3/4" x 30" IRON BAR WITH ALUMINUM CAP.	
BEARINGS ARE REFERENCED TO	
GRID NORTH AS PER SECTION DATA.	

Describe any record evidence, monument evidence, testimonial evidence or any other material evidence you considered and whether the monument was found or restored through acceptance of an obliterated evidence location.


I set the corner on line between the section corners and in the old North-South fence. This location fits the existing field evidence very well. I set an iron bar with cap at the corner.

Describe or show any material discrepancy between the location of the restored corner and that of the corner previously restored or reestablished.

None known.

RECORD OF DURABLE WITNESS MONUMENTS


NO	DESCRIPTION	BEARING	DISTANCE
1	SET A NAIL IN THE S.W.-SIDE OF AN 8" TREE	N 65°W (MAG.)	5.87 FT.
2	SET A NAIL IN THE N.E.-SIDE OF A 4" TREE	N. 'WESTERLY ±	14.23 FT.
3	SET A 3/4" x 30" IRON BAR 2' EAST OF FENCE	N. 'EASTERLY ±	13.00 FT.
4	SET A 3/4" x 30" IRON BAR 2' WEST OF FENCE	S. 'WESTERLY ±	15.50 FT.

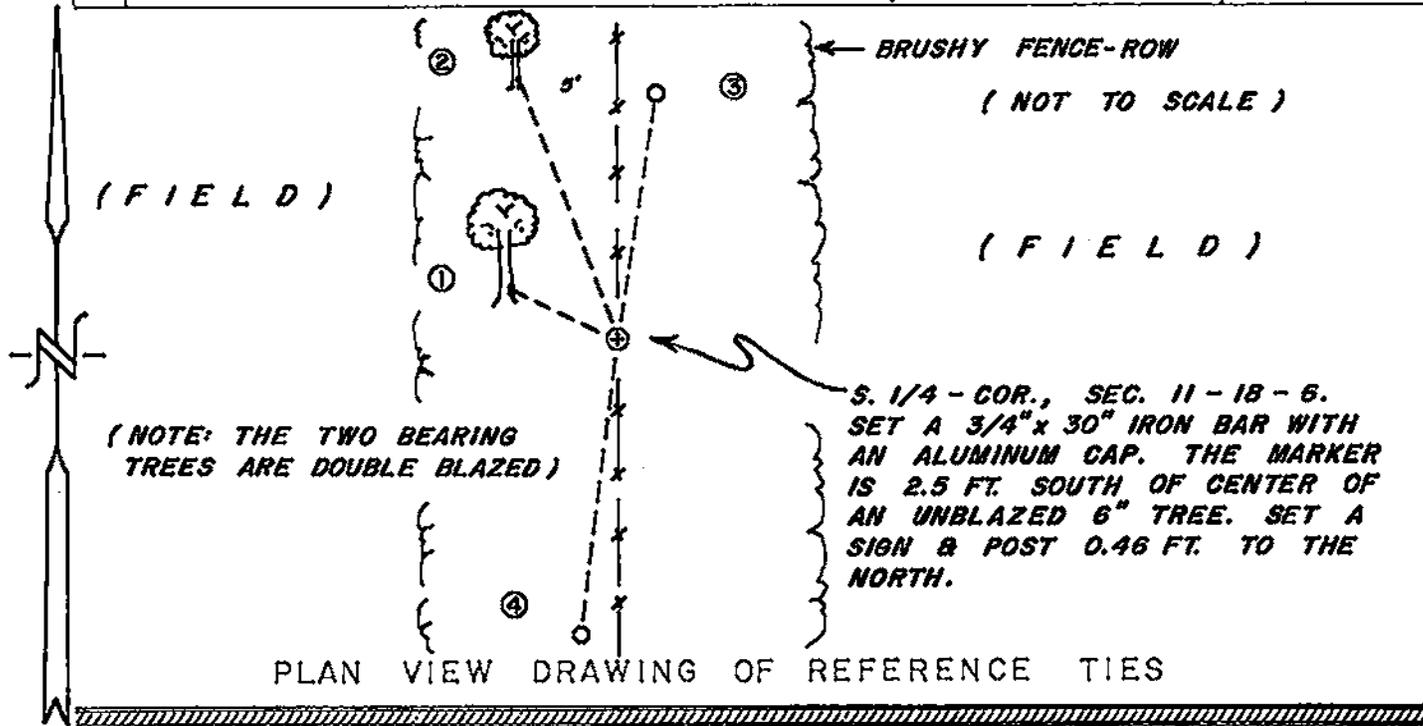

MAP SHOWING DISTANCE AND DIRECTION TO OTHER PUBLIC LAND SURVEY CORNERS USED FOR REESTABLISHING THE CORNER

(GRID BEARINGS & DISTANCES)

(not to scale)

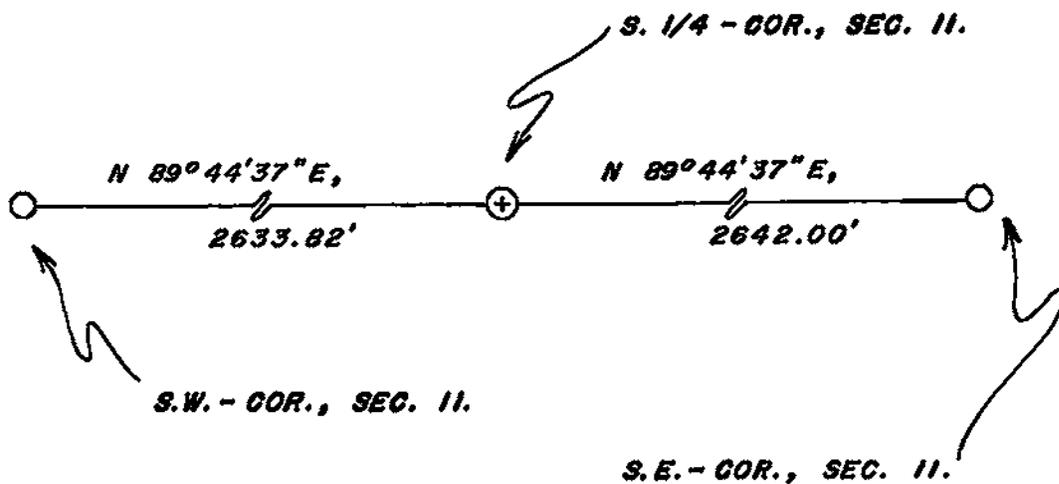

I, WILLIAM G. JUNG, COUNTY SURVEYOR
HEREBY CERTIFY THAT THE CORNER LOCATION SHOWN ON THIS RECORD WAS DETERMINED BY ME OR UNDER MY DIRECTION AND CONTROL AND THAT THIS U. S. PUBLIC LAND SURVEY MONUMENT RECORD IS CORRECT AND COMPLETE TO THE BEST OF MY KNOWLEDGE AND BELIEF.

William G. Jung
Signature

5/11/00
Date



Seal