


21806120000

## U. S. PUBLIC LAND SURVEY MONUMENT RECORD

SECTION 12 T 18 N, R 6 W, TOWN OF Farmington  
 LA CROSSE COUNTY

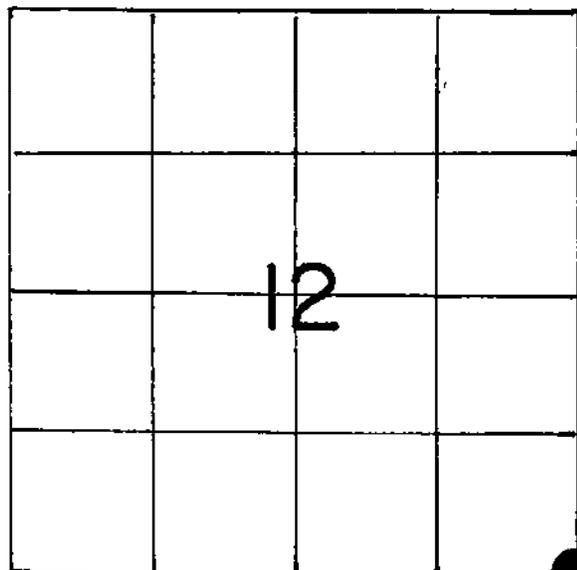

LOCATION OF LANDMARK

Crew: WILLIAM C. JUNG  
 PETER F. FOLLANSBEE

Date: 10/10/1991

Describe any record evidence, monument evidence, testimonial evidence or any other material evidence you considered and whether the monument was found or restored through acceptance of an obliterated evidence location.

I accepted the occupied fence corner as the best available evidence of the original government corner position and monumented it with a brass capped Lunde marker. This fence corner had been used as the corner in previous survey work by Solberg and Hurlburt. The Lunde is on the South side of the post. I found nothing while digging. I buried a liquor bottle with a shell casing on the Southwest side of the Lunde.

Describe or show any material discrepancy between the location of the restored corner and that of the corner previously restored or reestablished.

None known

## WISCONSIN COORDINATE SYSTEM

North

East

Theta Angle

Horiz. Order

Vert. Order


## TYPE OF LANDMARK

Set brass cap Lunde marker

BEARINGS ARE REFERENCED TO  
 Assumed North

**RECORD OF DURABLE WITNESS MONUMENTS**  
MAGNETIC


NO	DESCRIPTION	BEARING	DISTANCE
1	Set 1" Iron Pipe North of fence	West $\pm$	32.84 Ft.
2	Set P.K. Nail in SW-side 45" Burr Oak(unblzd) N 16° W		249.50 Ft.
3	Set 1" Iron Pipe East of fence	North $\pm$	33.10 Ft.
4	Set 1" Iron Pipe North of fence	East $\pm$	32.80 Ft.

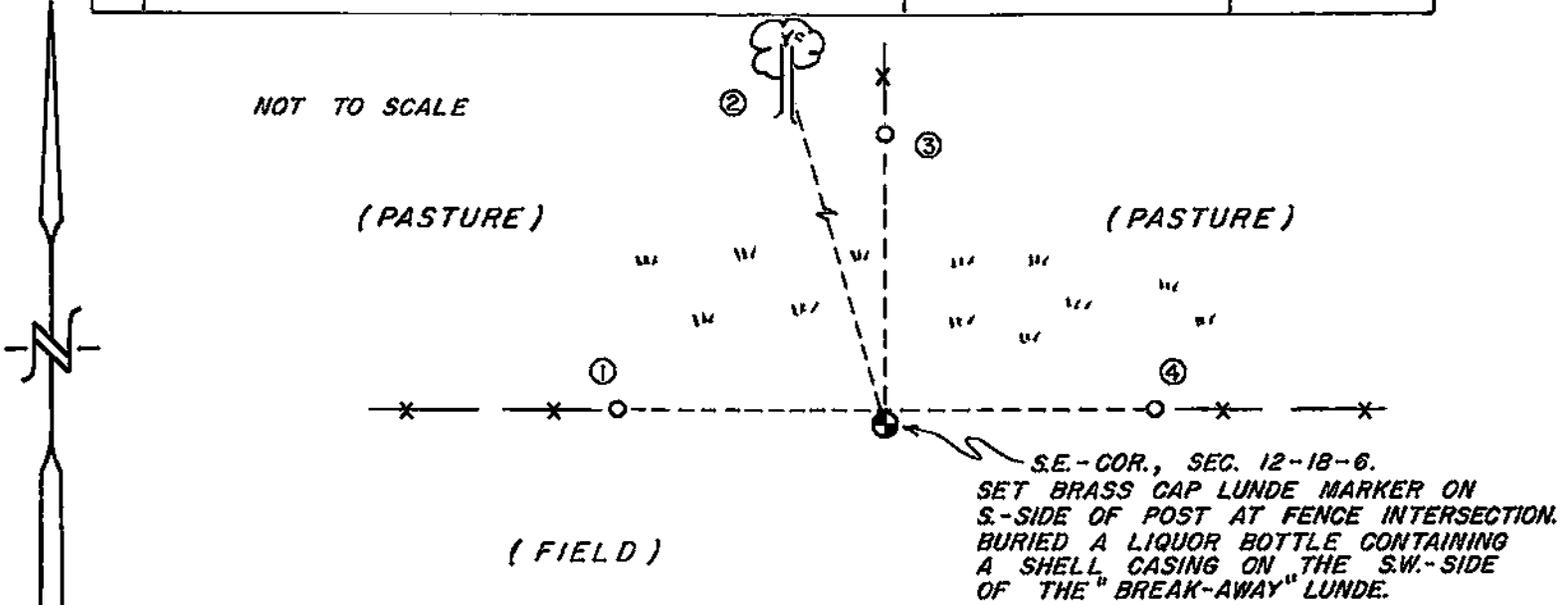

PLAN VIEW DRAWING OF REFERENCE TIES

**MAP SHOWING DISTANCE AND DIRECTION TO OTHER PUBLIC LAND SURVEY CORNERS USED FOR REESTABLISHING THE CORNER**


(not to scale)

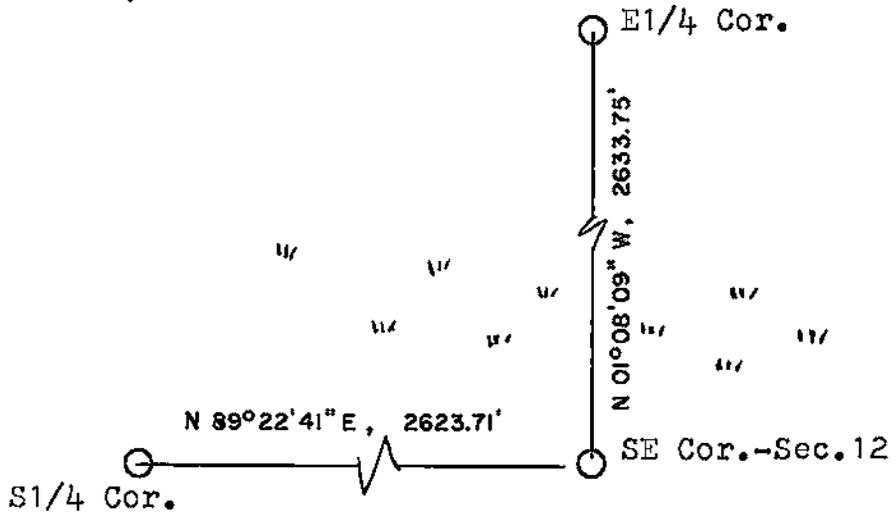

I, William C. Jung, Deputy County Surveyor  
HEREBY CERTIFY THAT THE CORNER LOCATION SHOWN ON THIS RECORD  
WAS DETERMINED BY ME OR UNDER MY DIRECTION AND CONTROL AND  
THAT THIS U. S. PUBLIC LAND SURVEY MONUMENT RECORD IS CORRECT  
AND COMPLETE TO THE BEST OF MY KNOWLEDGE AND BELIEF.

William C. Jung  
Signature

November 7, 1991  
Date

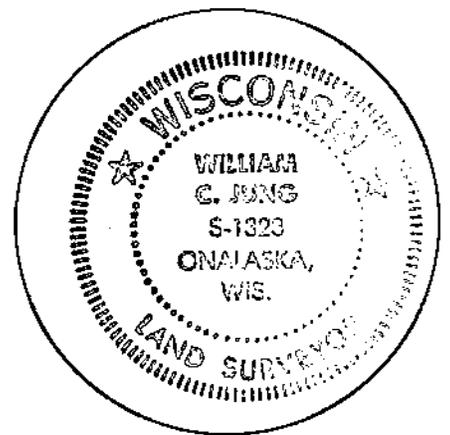

Seal