


U. S. PUBLIC LAND SURVEY MONUMENT RECORD

SECTION 12 T 18 N, R 6 W, TOWN OF Farmington
 LA CROSSE COUNTY

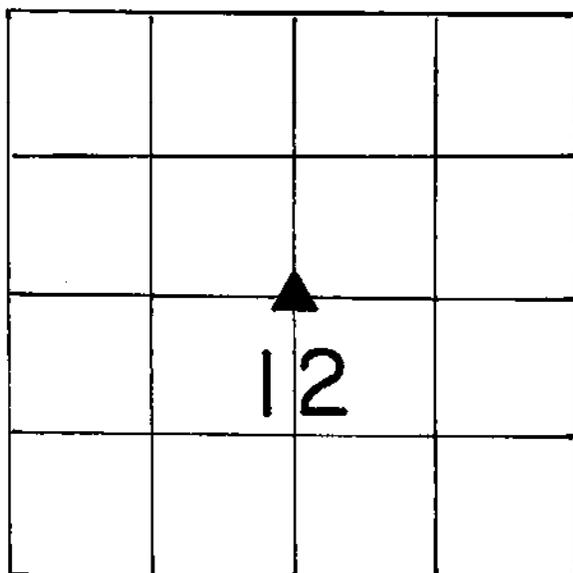

LOCATION OF LANDMARK

WISCONSIN COORDINATE SYSTEM
North
East
Theta Angle
Horiz. Order
Vert. Order
TYPE OF LANDMARK
Set Railroad Spike
BEARINGS ARE REFERENCED TO
Assumed

Crew: WILLIAM C. JUNG
 PETER F. FOLLANSBEE
 Date: 9/30/1991

Describe any record evidence, monument evidence, testimonial evidence or any other material evidence you considered and whether the monument was found or restored through acceptance of an obliterated evidence location.


After "running out" Section 12, I accepted the occupied Center 1/4 Corner as the best available evidence of the position of this corner as established in previous survey work. It falls 1.87' North and 0.25' East of the true Center 1/4 Corner position. I have no record of this Center 1/4 Corner as having been set, but considering how this occupied corner fits the section, especially the church and school (etc.) fences to the North, South, East, and West, it is my opinion that some unknown surveyor set this corner at this location sometime in the past.

Describe or show any material discrepancy between the location of the restored corner and that of the corner previously restored or reestablished.

None known (see above notes)


RECORD OF DURABLE WITNESS MONUMENTS

NO	DESCRIPTION	BEARING	DISTANCE
1	Existing P.K. Nail in centerline CTH "C"	South \pm	300.50'
2	Set P.K. Nail in SW-side power pole	Southeast \pm	52.66'
3	Set P.K. Nail in NE-side 18" Cedar	Southeast \pm	53.65'
4	Set P.K. Nail in SE-side power pole	Northeast \pm	45.50'
5	Set P.K. Nail in SE-side large Maple	Northwest \pm	53.46'

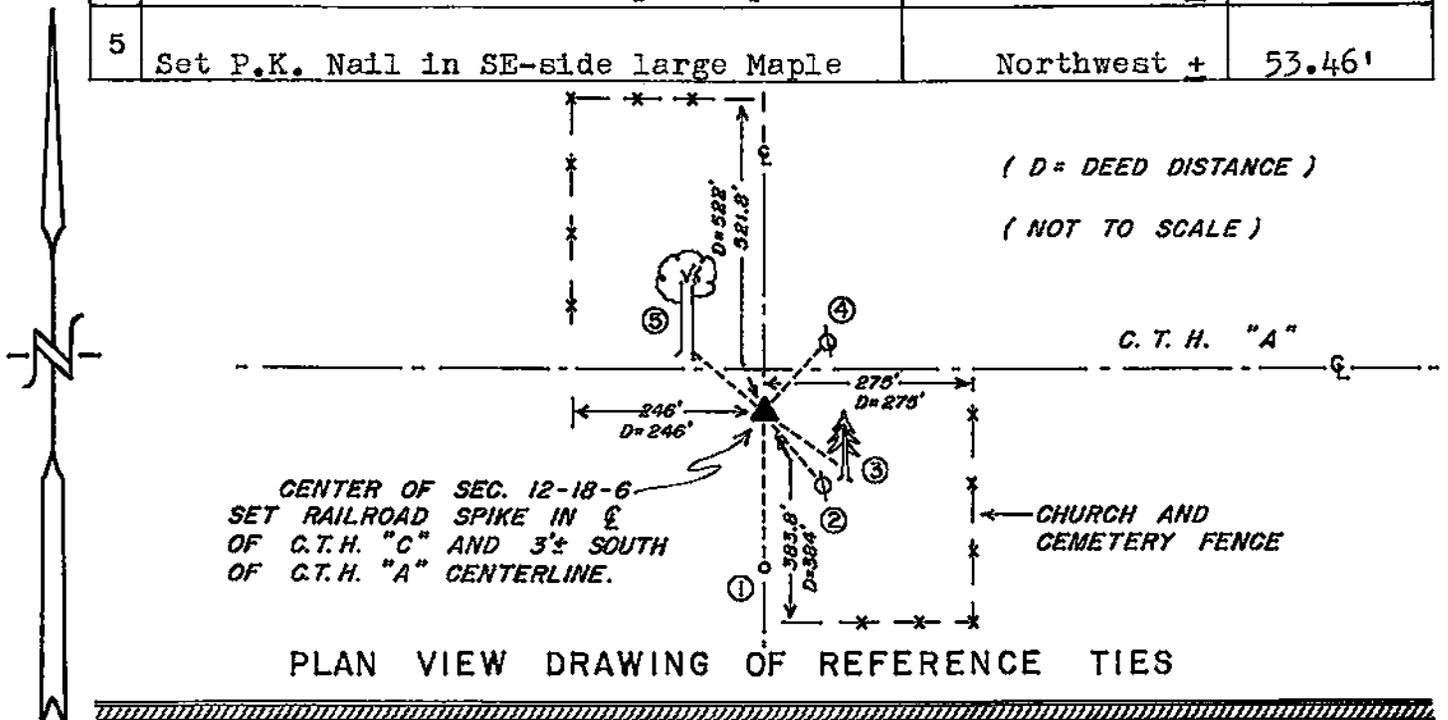

MAP SHOWING DISTANCE AND DIRECTION TO OTHER PUBLIC LAND SURVEY CORNERS USED FOR REESTABLISHING THE CORNER

(not to scale)

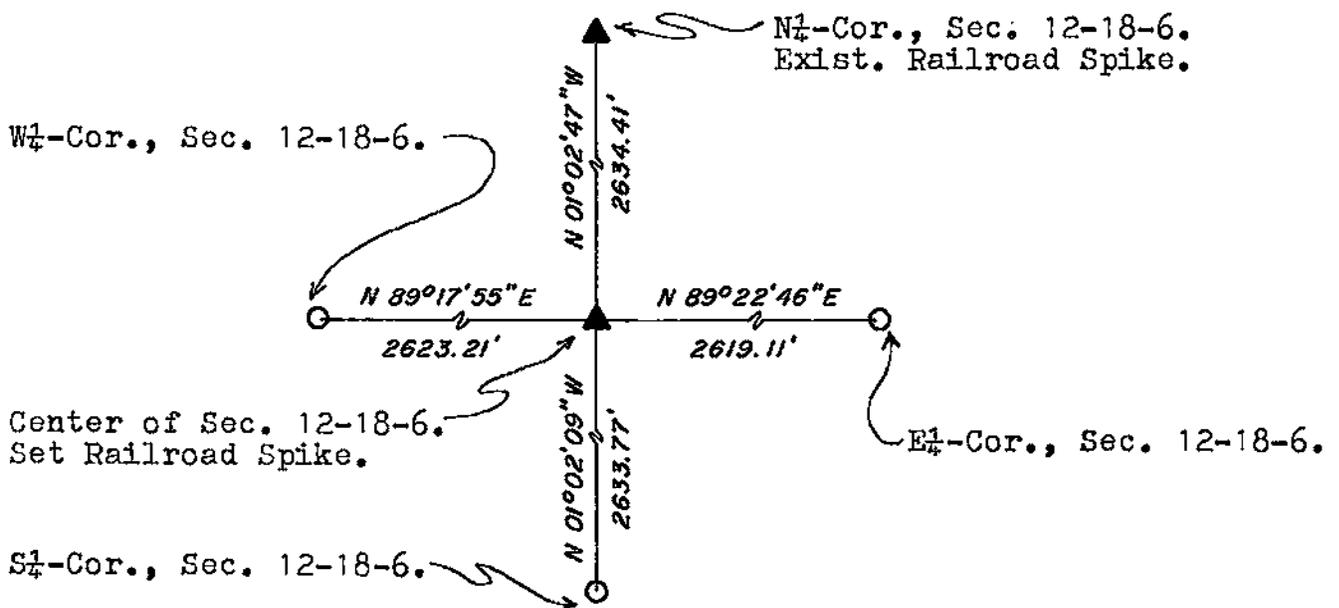

I, William C. Jung, Deputy County Surveyor
HEREBY CERTIFY THAT THE CORNER LOCATION SHOWN ON THIS RECORD
WAS DETERMINED BY ME OR UNDER MY DIRECTION AND CONTROL AND
THAT THIS U. S. PUBLIC LAND SURVEY MONUMENT RECORD IS CORRECT
AND COMPLETE TO THE BEST OF MY KNOWLEDGE AND BELIEF.

William C. Jung
Signature

March 18, 1992
Date

