


## U. S. PUBLIC LAND SURVEY MONUMENT RECORD

SECTION 24 T 18 N, R 6 W, TOWN OF Farmington

LA CROSSE COUNTY

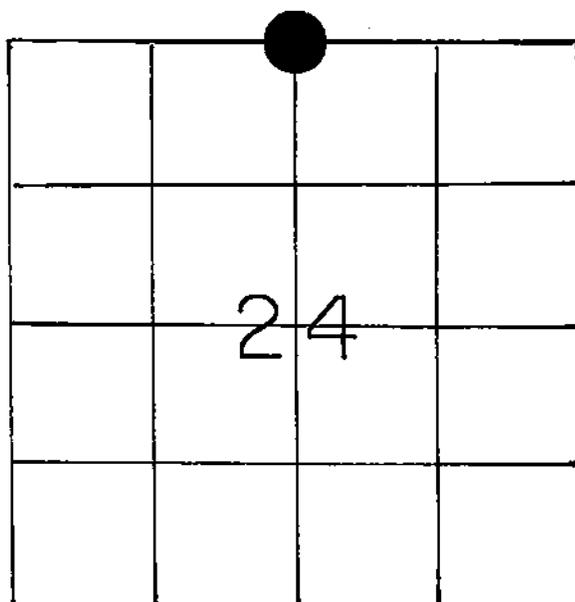

LOCATION OF LANDMARK

Crew: WILLIAM C. JUNG

Date: 11/17/1988

Describe any record evidence, monument evidence, testimonial evidence or any other material evidence you considered and whether the monument was found or restored through acceptance of an obliterated evidence location.

Norm Hurlburt and I believe that the white oak bearing tree shown as ③ on the rear of this tie sheet is an original bearing tree. The corner was set off this tree. I set a brass capped Lunde marker at the corner. I buried a German wine bottle as a memorial on the West side of the Lunde marker.

Describe or show any material discrepancy between the location of the restored corner and that of the corner previously restored or reestablished.

NONE KNOWN

## WISCONSIN COORDINATE SYSTEM

North

East

Theta Angle

Horiz. Order

Vert. Order

## TYPE OF LANDMARK

Set Brass Cap Lunde Marker

## BEARINGS ARE REFERENCED TO

Assumed

RECORD OF DURABLE WITNESS MONUMENTS  
MAGNETIC

NO	DESCRIPTION	BEARING	DISTANCE
1	Set P.K. Nail in 22" White Oak	-----	55.5 Ft.
2	Set P.K. Nail in 24" White Oak	-----	S1=71.80'
3	Set P.K. Nail in 24" White Oak	S 83° E ±	S1=52.50'
4	Set P.K. Nail in 24" White Oak	-----	12.65 Ft.

NOTE: All distances are to P.K. Nails in hacks in single blazed White Oaks.

SCALE: 1" = 30'

North 1/4 Cor., Sec. 24-18-6.  
Set brass cap lunde marker up 4", 2' West and 0.8' North of fence corner.

Tree is 4' East of fence. Blaze is over old scar.

( WOODS )

( FIELD )

LANE

( FIELD )

PLAN VIEW DRAWING OF REFERENCE TIES

MAP SHOWING DISTANCE AND DIRECTION TO OTHER PUBLIC LAND SURVEY CORNERS USED FOR REESTABLISHING THE CORNER

(not to scale)

○ N1/4 Cor.


NO-09-49E, 5257.05  
(Hurlburt measurements)

○ S1/4 Cor.

I, William C. Jung, Deputy County Surveyor  
HEREBY CERTIFY THAT THE CORNER LOCATION SHOWN ON THIS RECORD WAS DETERMINED BY ME OR UNDER MY DIRECTION AND CONTROL AND THAT THIS U. S. PUBLIC LAND SURVEY MONUMENT RECORD IS CORRECT AND COMPLETE TO THE BEST OF MY KNOWLEDGE AND BELIEF.

William C. Jung  
Signature

1/18/89  
Date

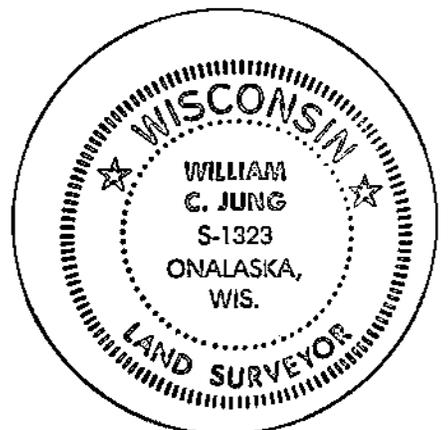

Seal