


21806142000

## U. S. PUBLIC LAND SURVEY MONUMENT RECORD

SECTION 14 T 18 N, R 6 W, TOWN OF FARMINGTON

LA CROSSE COUNTY

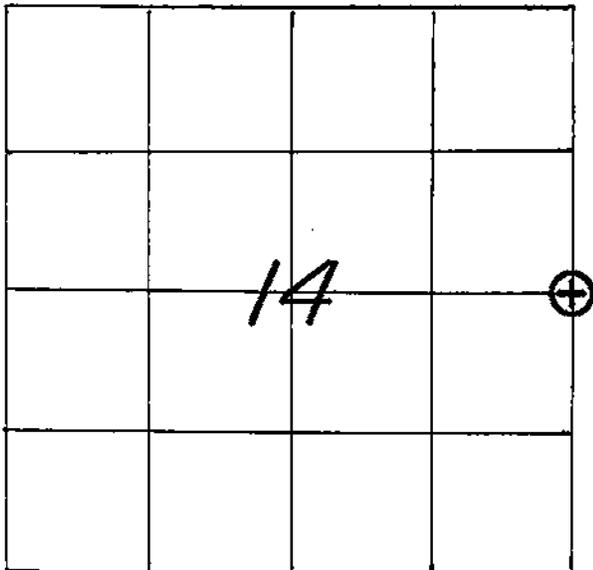

LOCATION OF LANDMARK

CREW: **WILLIAM C. JUNG**  
**PETER F. FOLLANSBEE**  
 DATE: **12/09/2002**

## WISCONSIN COORDINATE SYSTEM

North **743,684.045**East **1,691,777.364**

Theta Angle

Horiz. Order

Vert. Order

DATUM: **1983('91)**

## TYPE OF LANDMARK

**3/4" x 30" IRON BAR WITH ALUMINUM CAP.**

BEARINGS ARE REFERENCED TO

**GRID NORTH AS PER SECTION DATA.**


Describe any record evidence, monument evidence, testimonial evidence or any other material evidence you considered and whether the monument was found or restored through acceptance of an obliterated evidence location.

I set this corner in the old existing North-South fence and equidistant between the section corners. This falls about four feet North of the old North-South fence tie post where the old farmers split their fencing. Also, nine rods to the North is a deed line to the East. If one extends the old occupied line on this line West to the section line, and then measures South to the 1/4 corner, the final corner fits that  $\pm$  occupation within two feet or so. I set an iron bar with a cap at the corner. Describe or show any material discrepancy between the location of the restored corner and that of the corner previously restored or reestablished.


**NONE KNOWN.**

RECORD OF DURABLE WITNESS MONUMENTS

NO	DESCRIPTION	BEARING	DISTANCE
1	SET A 3/4" x 30" IRON BAR WITH AN ALUMINUM CAP	N 87° W	24.36 FT.
2	SET A NAIL IN S.E.-SIDE OF A 7" HICKORY	N 31° E	2.36 FT.
3	SET A NAIL IN S.W.-SIDE OF A 13" BLACK WALNUT	S 67° E	6.03 FT.
4	SET A NAIL IN N.E.-SIDE OF A 3-1/2" WHITE OAK	S 48° E	0.92 FT.

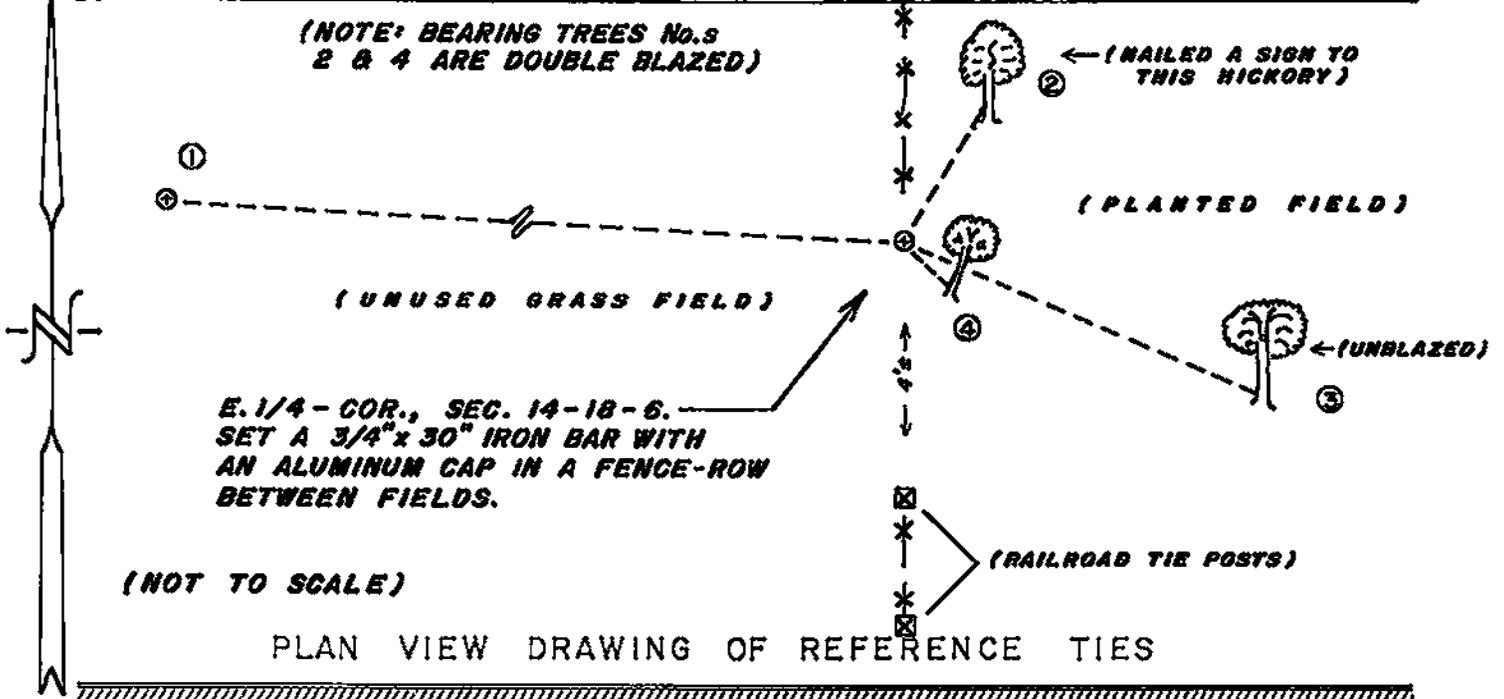

MAP SHOWING DISTANCE AND DIRECTION TO OTHER PUBLIC LAND SURVEY CORNERS USED FOR REESTABLISHING THE CORNER

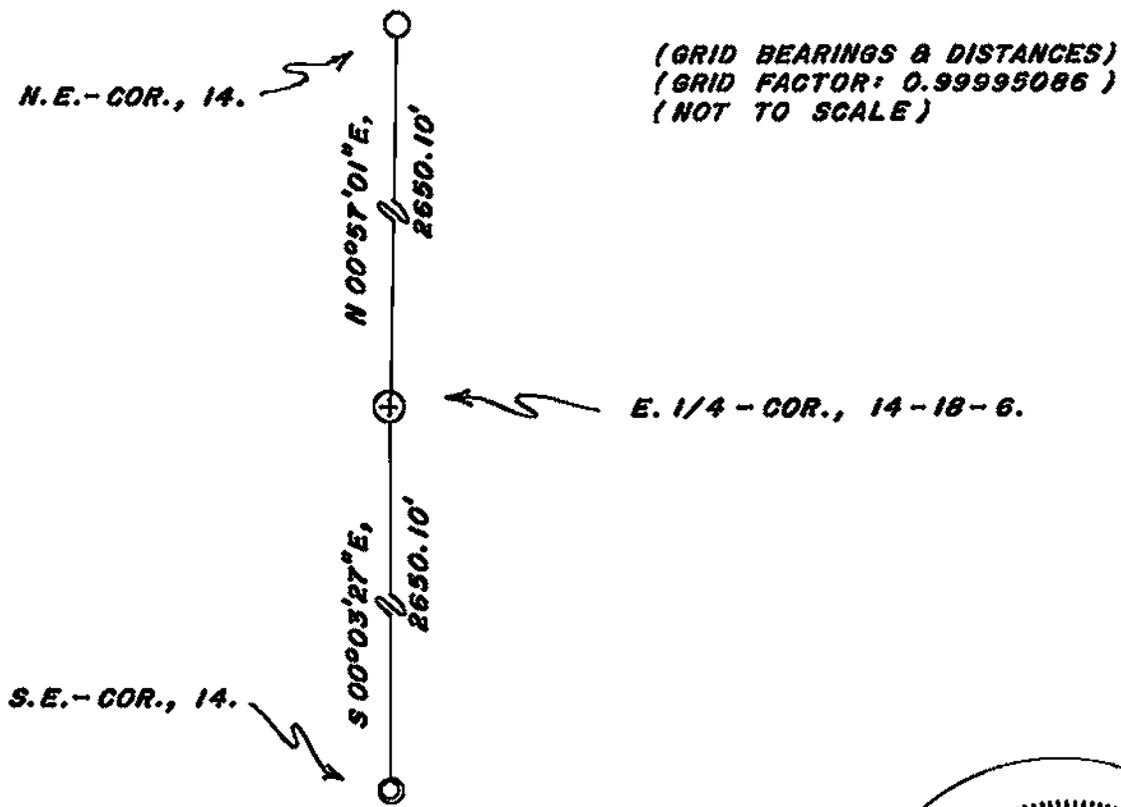

I, WILLIAM C. JUNG, COUNTY SURVEYOR  
HEREBY CERTIFY THAT THE CORNER LOCATION SHOWN ON THIS RECORD WAS DETERMINED BY ME OR UNDER MY DIRECTION AND CONTROL AND THAT THIS U. S. PUBLIC LAND SURVEY MONUMENT RECORD IS CORRECT AND COMPLETE TO THE BEST OF MY KNOWLEDGE AND BELIEF.

William C. Jung  
Signature

1/13/03  
Date



Seal